


SUITE 125  
AS BUILT - 1 OF 1  
CALHOUN BUILDING - LEVEL TWO  
633 USF / 728 RSF  
SCALE: 1/8" = 1'-0"  
DATE: JANUARY 14, 2015



KEY PLAN

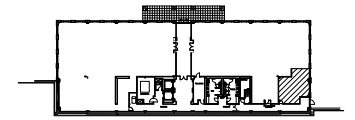