


Harris Building

SUITE 1000
26,248 RSF

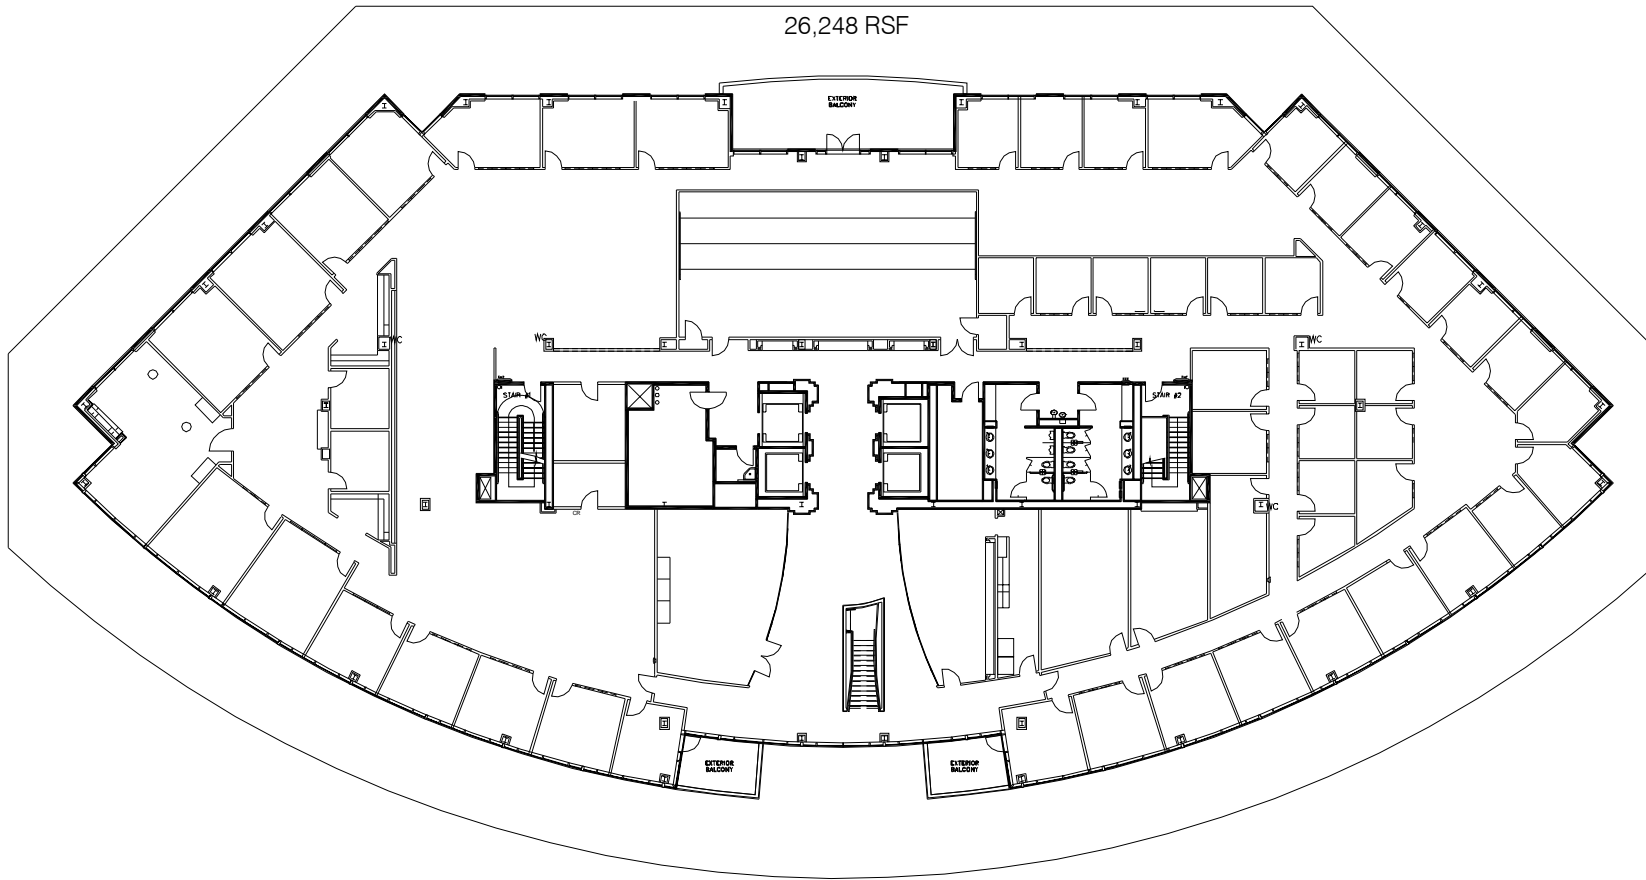

13024 Ballantyne Corporate Place

Level Ten

As Built

July 9, 2010

Not to Scale




13860 Ballantyne Corporate Place

Suite 300

Charlotte, N.C. 28277

(704) 248-2000

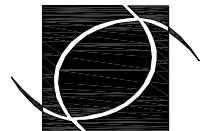

**SMITH
HARRIS**
DESIGN
associates