

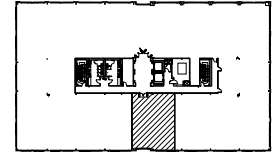


SUITE 415

AS BUILT - 1 OF 1
IRBY BUILDING - LEVEL FOUR
1,872 USF / 2,152 RSF SCALE:
1/8" = 1'-0"
DATE: SEPTEMBER 22, 2014

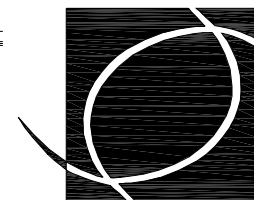

KEY PLAN

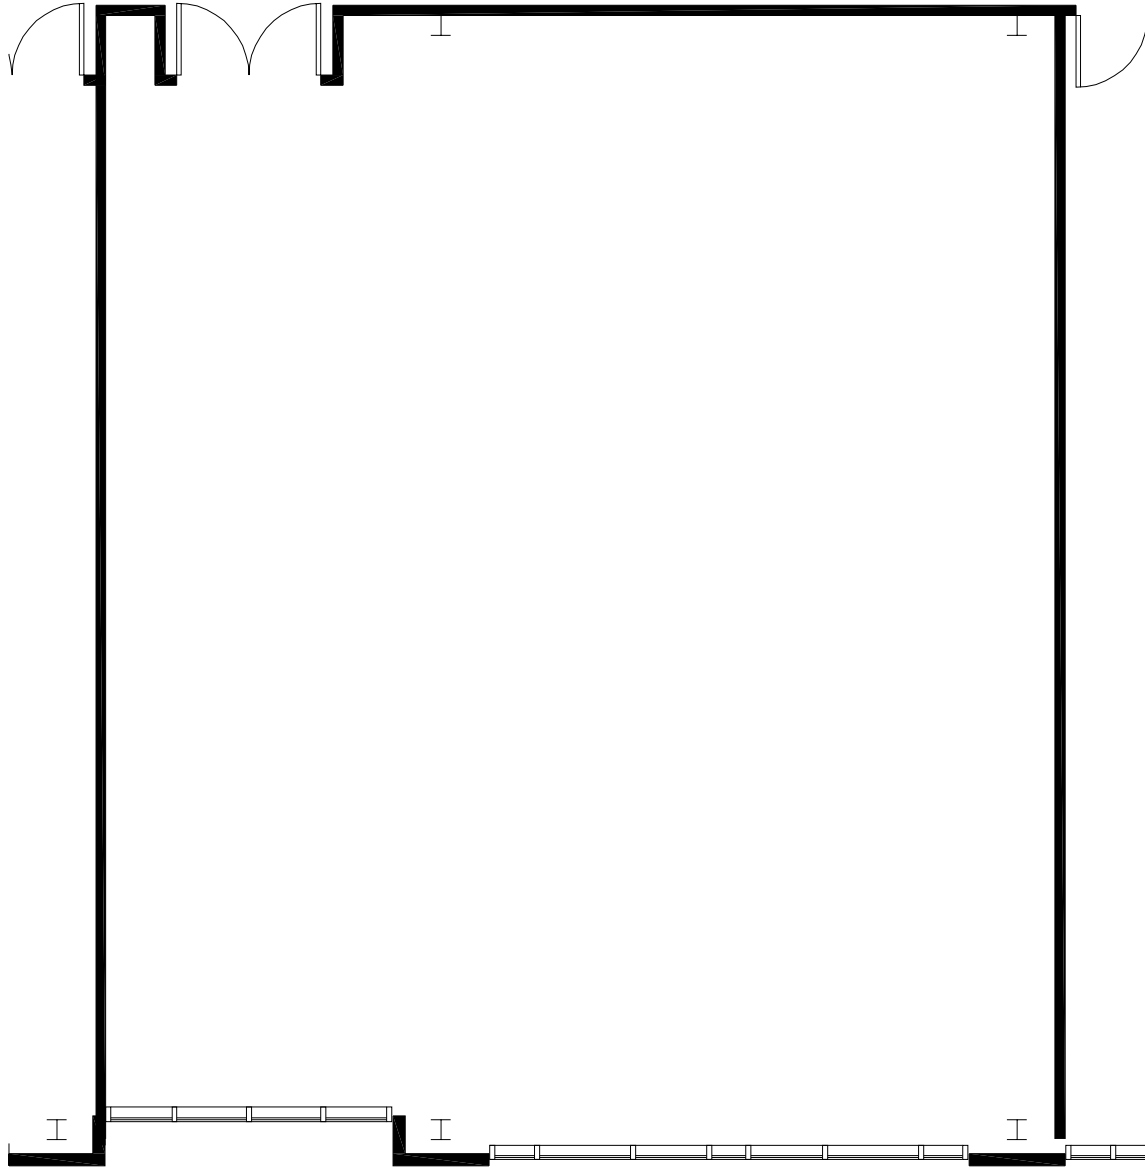

SMITH
HARRIS
DESIGN
associates