

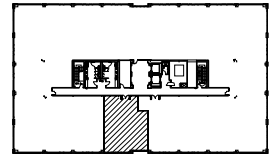


SUITE 635
AS BUILT - 1 OF 1
IRBY BUILDING - LEVEL SIX
1,574 USF / 1,810 RSF
SCALE: 1/8" = 1'-0"
DATE: JULY 30, 2014

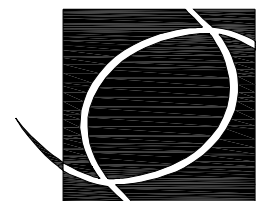

KEY PLAN

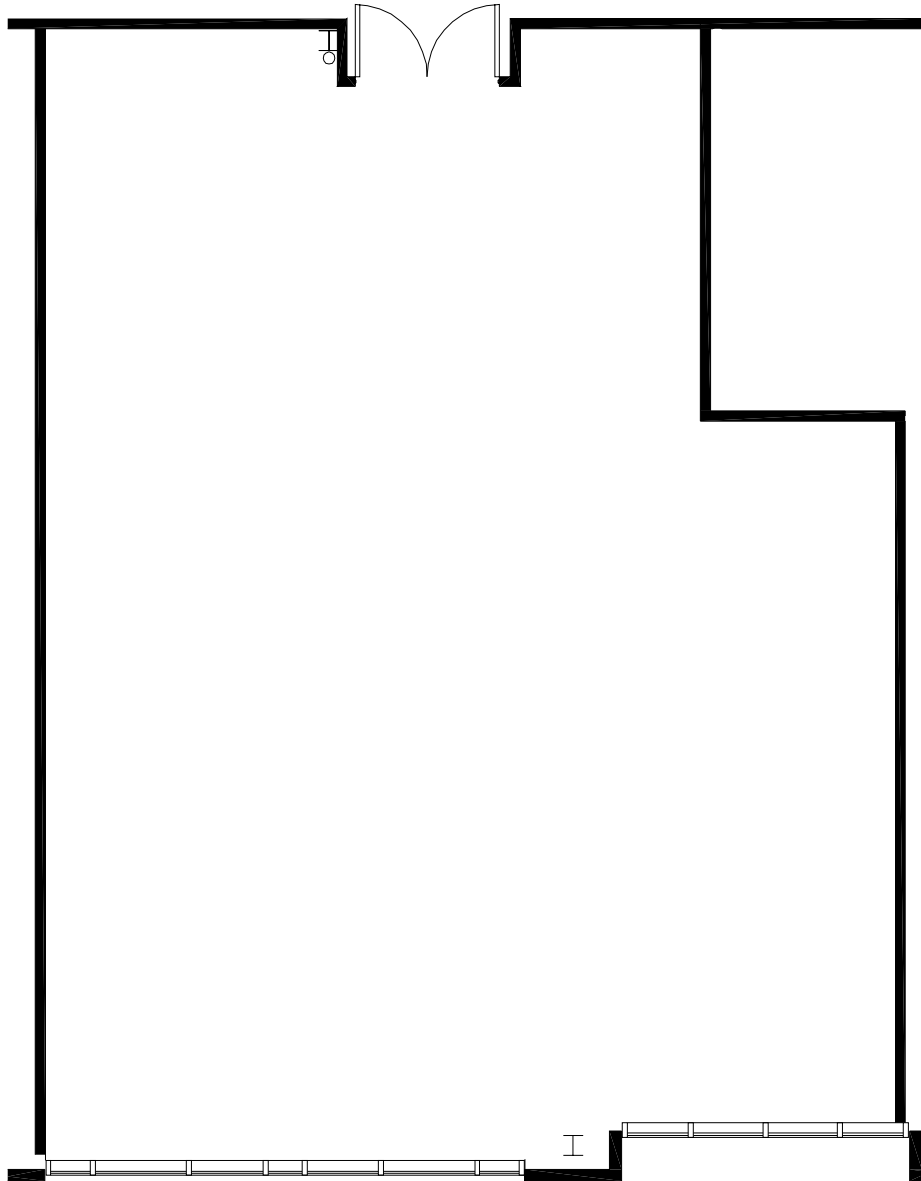

SMITH
HARRIS
DESIGN
associates