



SUITE 160
AS BUILT - 1 OF 1
HARPER BUILDING - LEVEL ONE
2,114 USF/ 2,368 RSF
SCALE: 1/8" = 1'-0"
DATE: MARCH 9, 2017

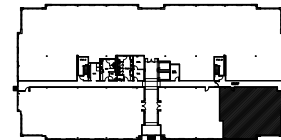

KEY PLAN

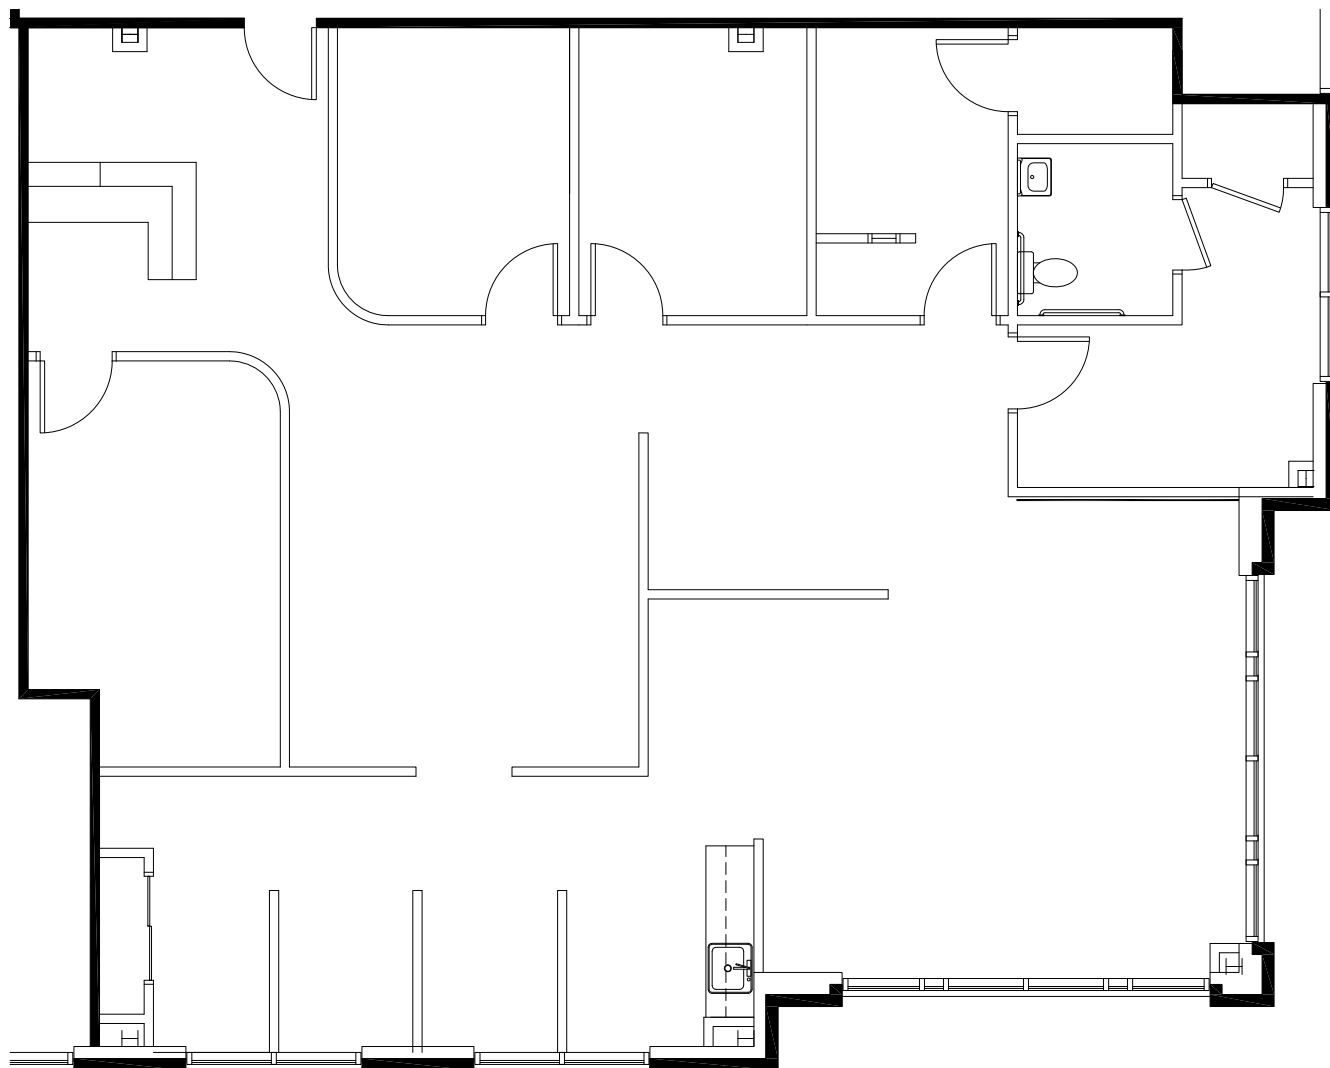

SMITH HARRIS DESIGN ASSOCIATES IS NOT
LIABLE OR RESPONSIBLE FOR THE INFORMATION
CONTAINED WITHIN. IT IS THE USERS'
RESPONSIBILITY TO FIELD MEASURE THE SPACE
FOR THEIR USE. PLANS ARE FROM ARCHIVE
BUILDING FILES AND MIGHT NOT CONTAIN
VERIFIED OR UPDATED INFORMATION.

