




AVAILABLE
AS-BUILT PLAN - 1 OF 1
EVERETT- SUITE 650
9,609/ 11,445 RSF
NOT TO SCALE
DATE: MAY 11, 2017

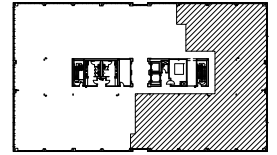

KEY PLAN

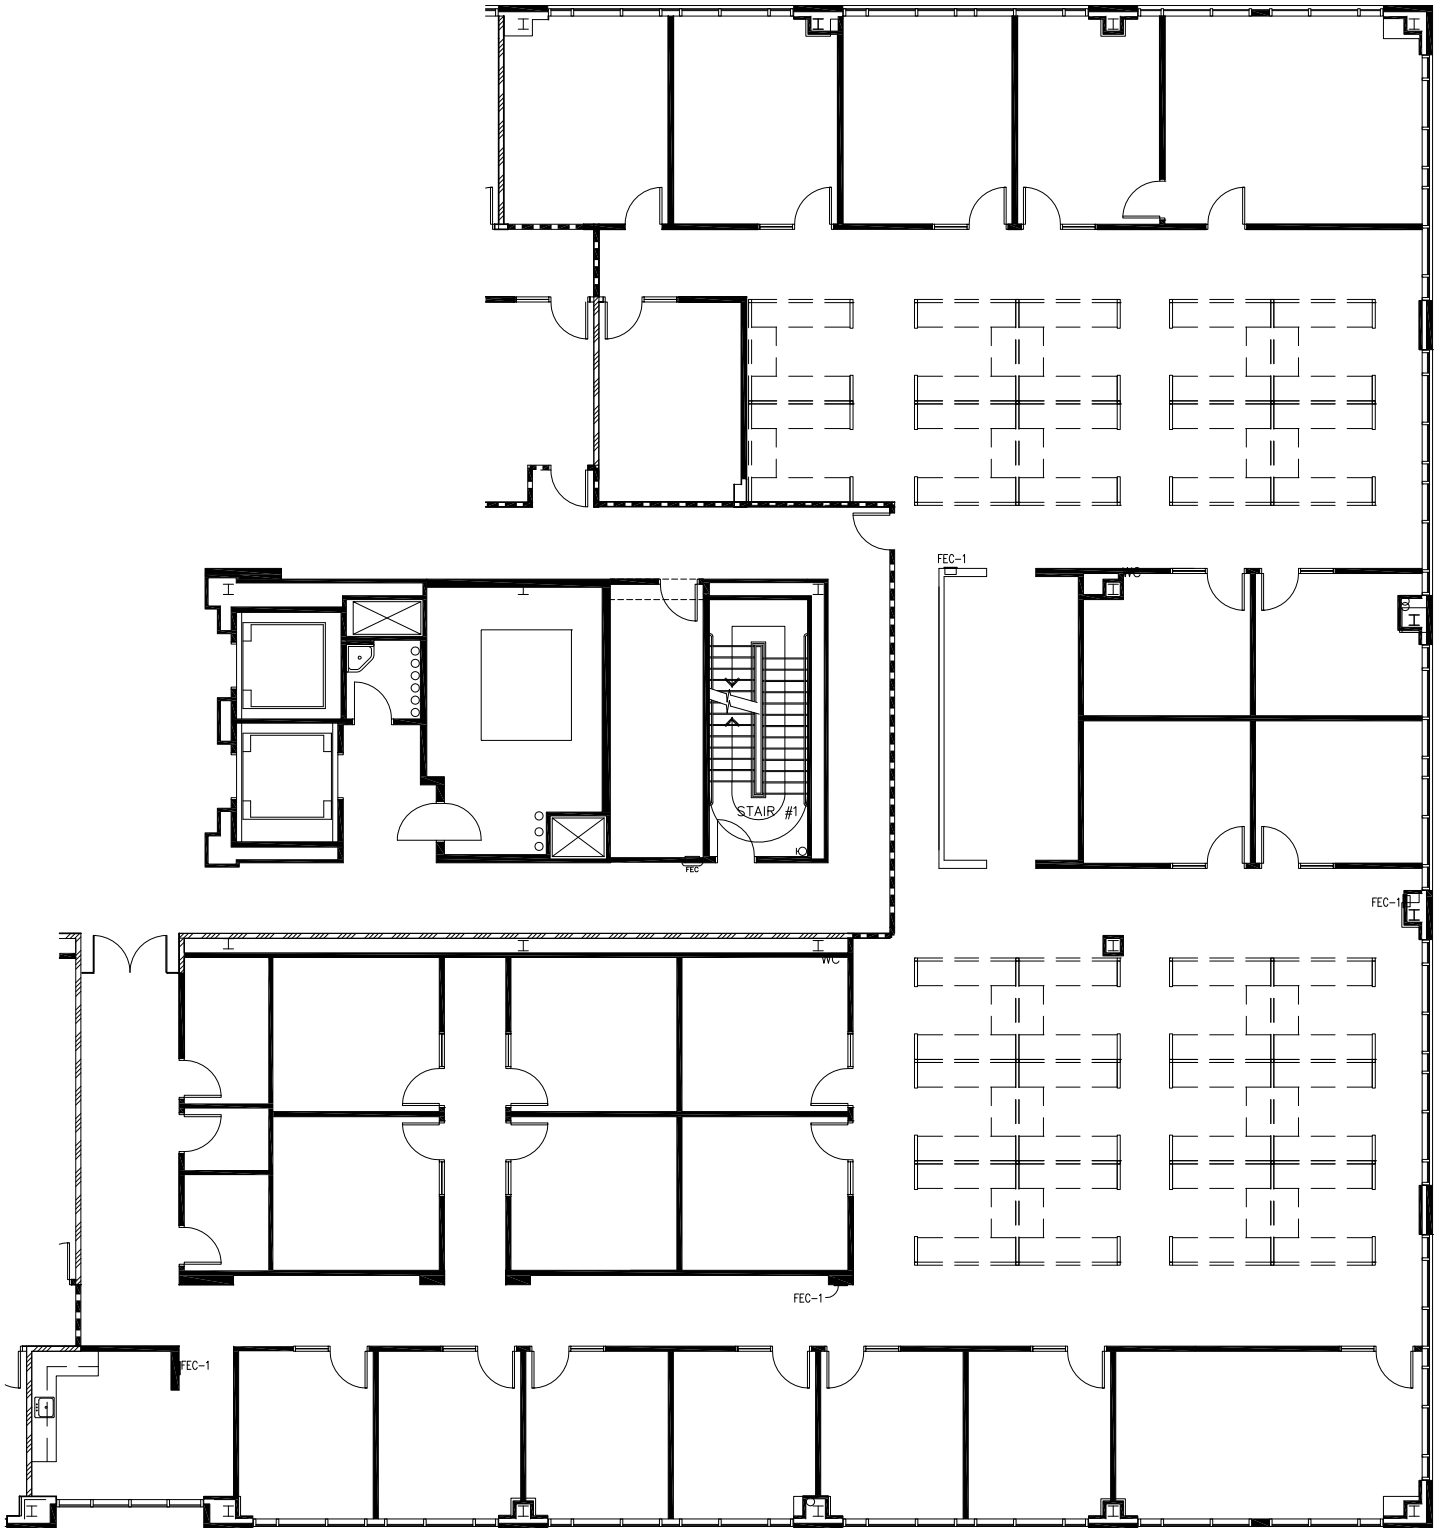

NORTHWOOD
OFFICE

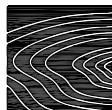

**SMITH
HARRIS**
DESIGN
associates