

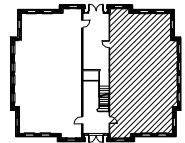


SUITE 100
AS BUILT - 1 OF 1
CORPORATE VILLA A - LEVEL ONE
1,380 USF
SCALE: 1/8" = 1'-0"
DATE: APRIL 20, 2011

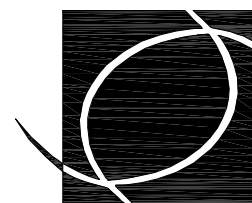

KEY PLAN

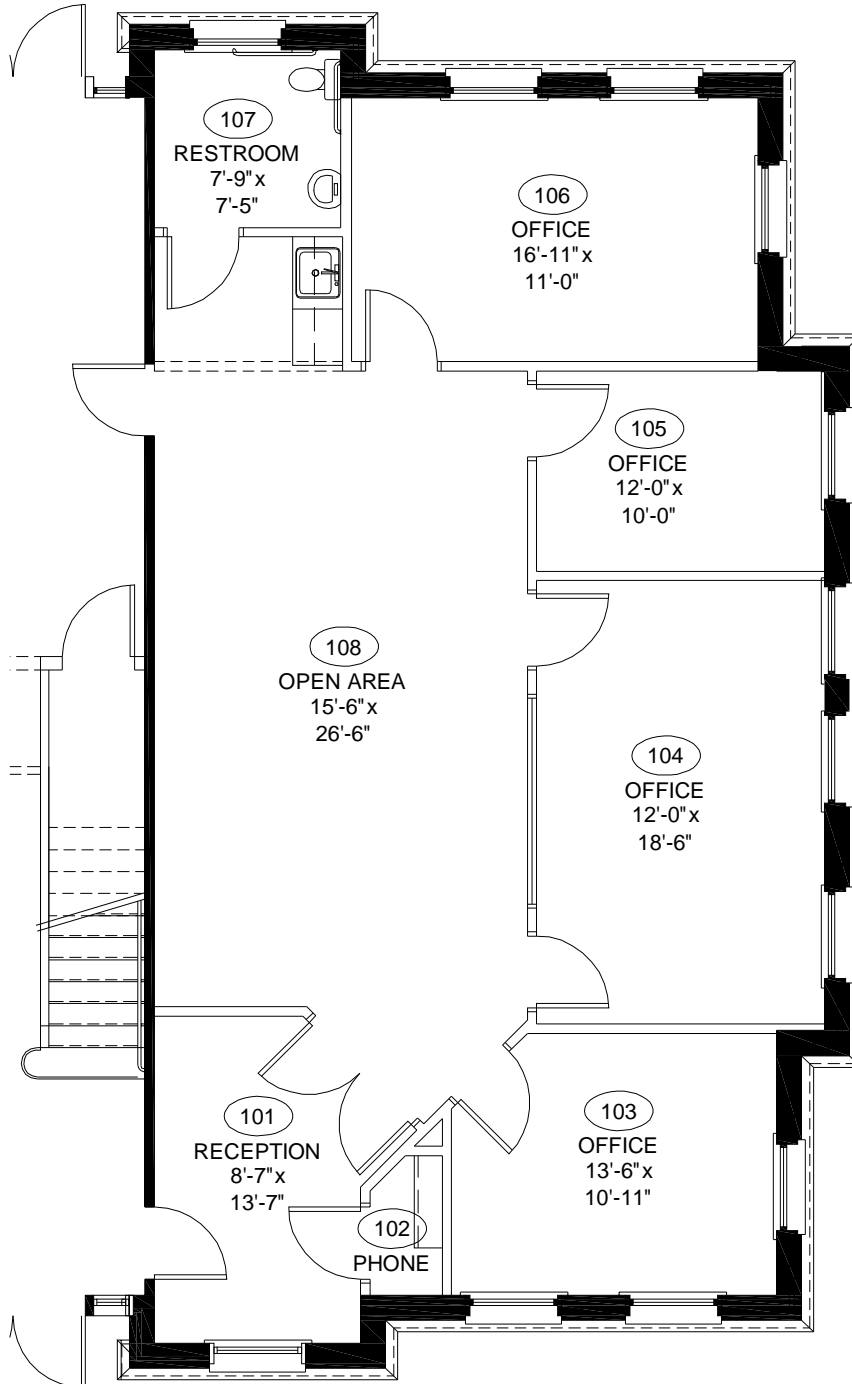

SMITH
HARRIS
DESIGN
associates