


SUITE 300

23,801 USF / 26,181 RSF

Irby  
Building

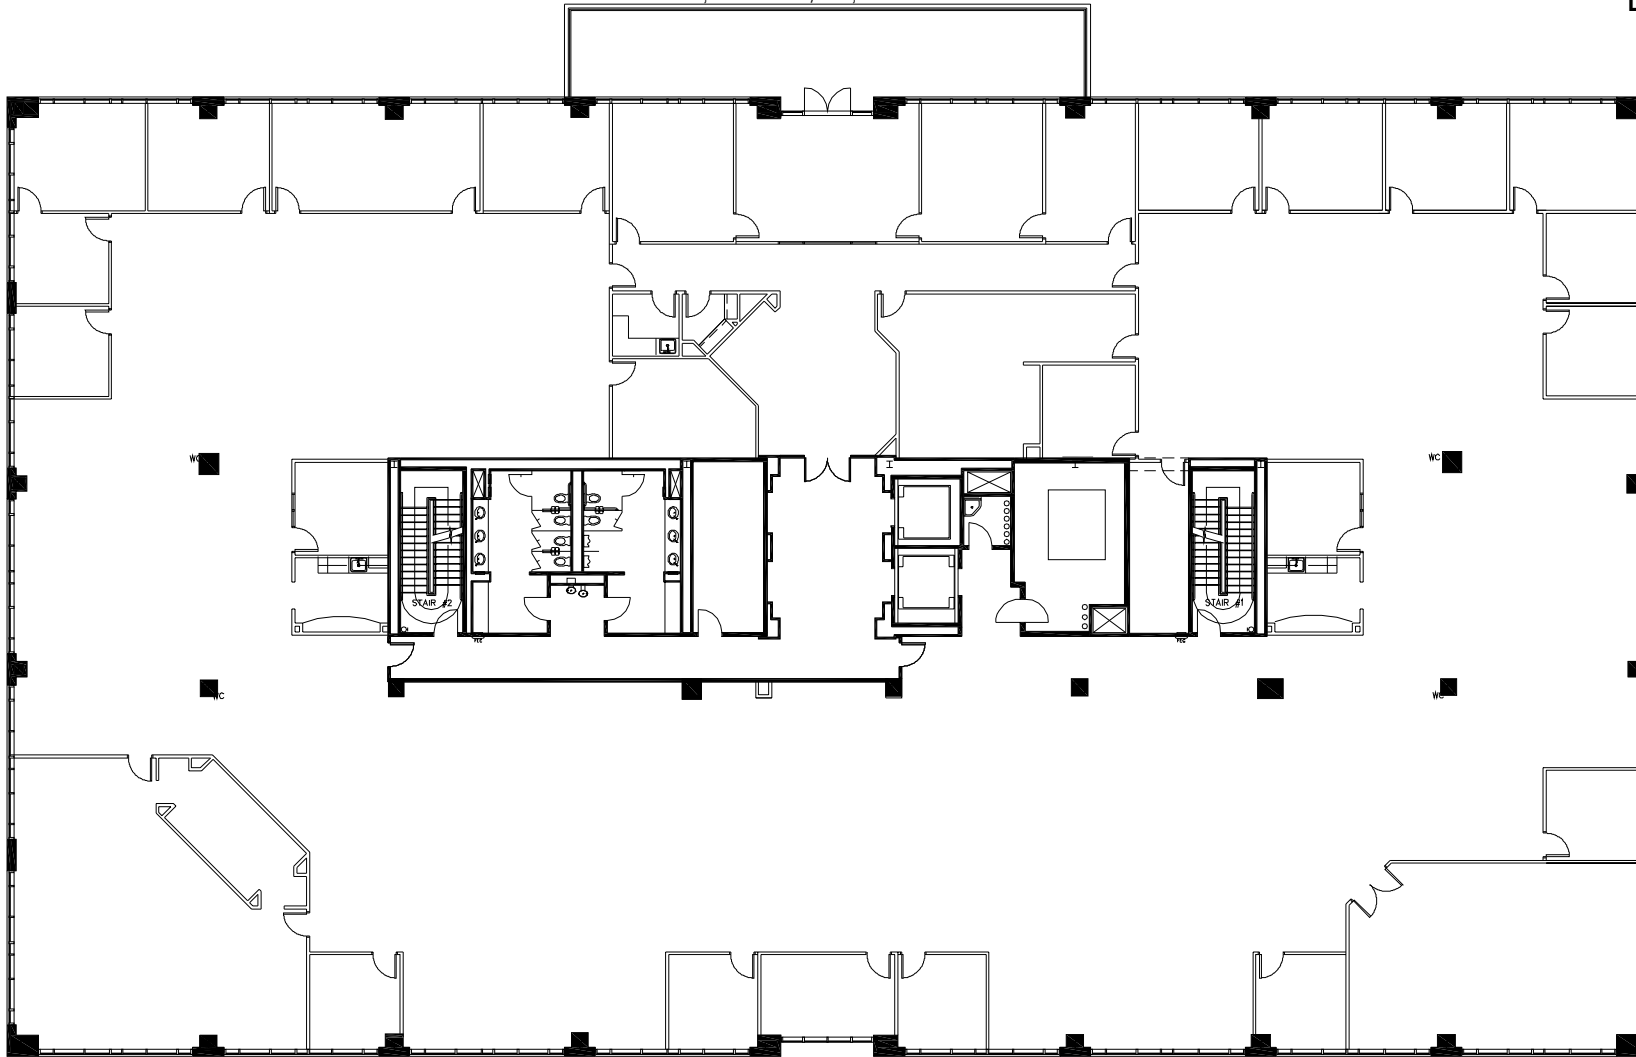

11325 North  
Community House Rd

Level  
Three

As Built

July 9, 2010

Not to Scale

**Bissell**  
DEVELOPMENT

13860 Ballantyne Corporate Place

Suite 300

Charlotte, N.C. 28277

(704) 248-2000



**SMITH  
HARRIS**  
DESIGN  
associates