



SUITE 100  
AS BUILT - 1 OF 1  
SIMMONS BUILDING - LEVEL ONE  
4,190 USF / 4,819 RSF  
SCALE: 3/32" = 1'-0"  
DATE: JULY 14, 2017

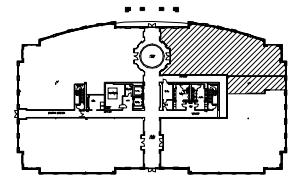

KEY PLAN

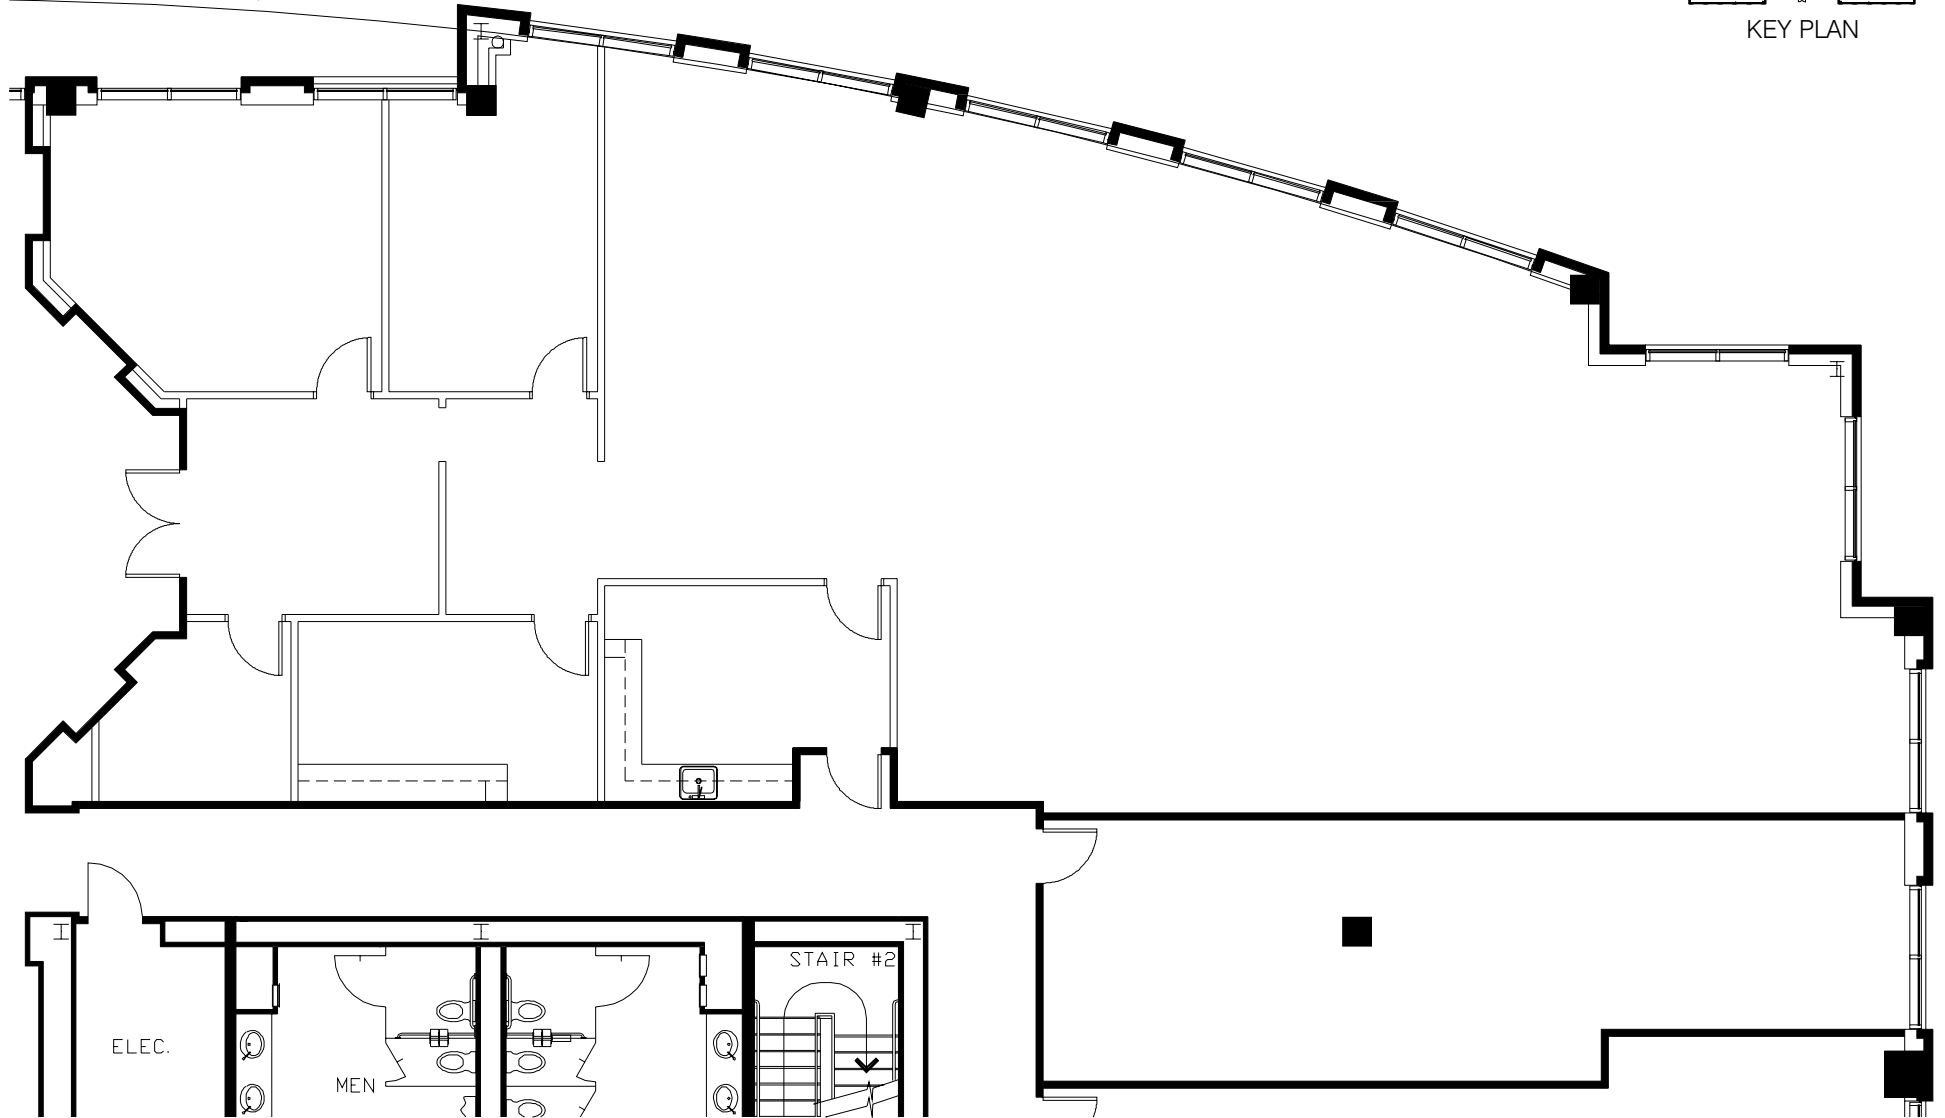

**NORTHWOOD**  
OFFICE



**SMITH  
HARRIS**  
DESIGN  
associates