



SUITE 320
AS BUILT - 1 OF 1
HARRIS - LEVEL 3
1,518 USF/1,746 RSF
SCALE: 1/8" = 1'-0"
DATE: AUGUST 5, 2009

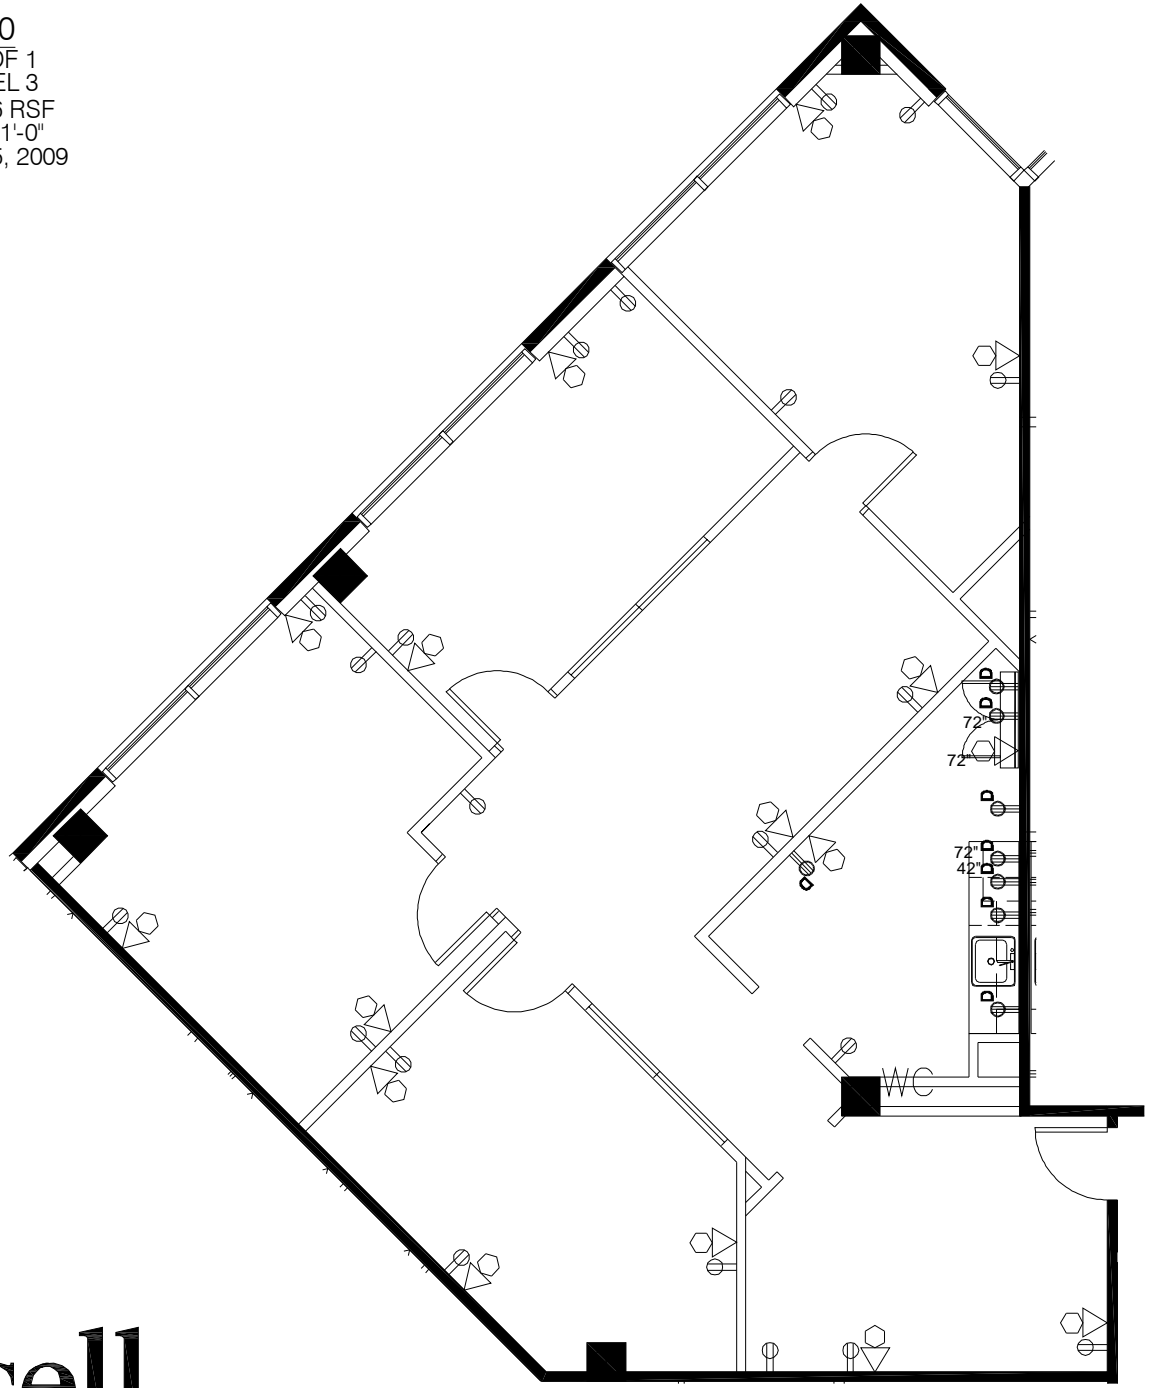

Bissell
DEVELOPMENT

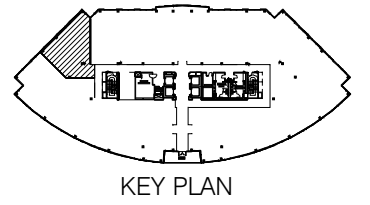

**SMITH
HARRIS
DESIGN**
associates