



SUITE 350  
AS BUILT - 1 OF 1  
HARRIS - LEVEL 3  
1,547 USF/1,779 RSF  
SCALE: 1/8" = 1'-0"  
DATE: AUGUST 5, 2009

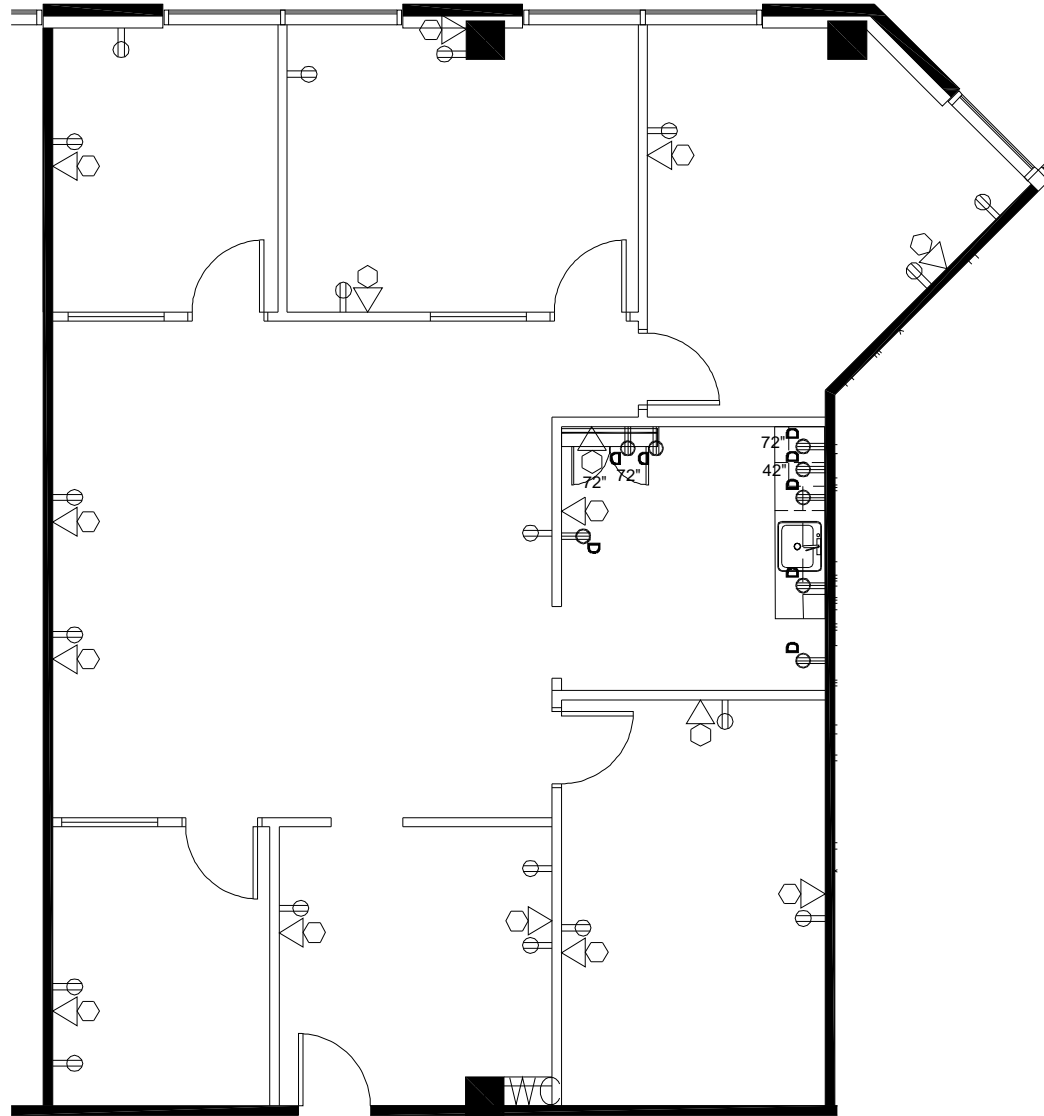

**Bissell**  
DEVELOPMENT

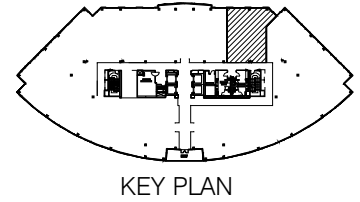

**SMITH  
HARRIS  
DESIGN**  
associates