
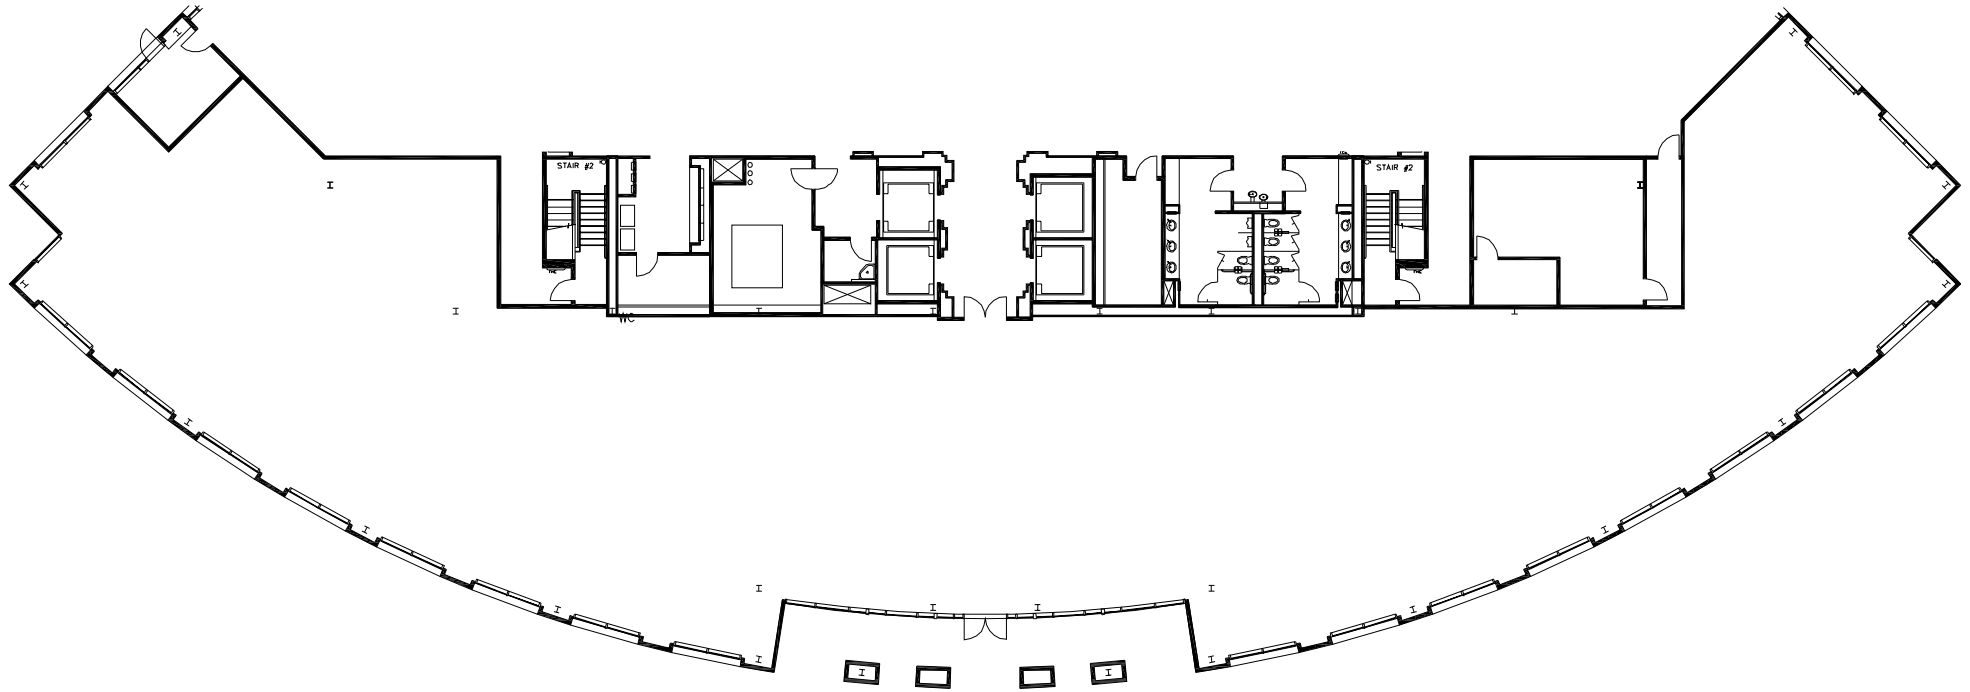


SUITE 150
AS BUILT - 1 OF 1
HARRIS BUILDING - LEVEL ONE
11,876 USF/ 13,657 RSF
NOT TO SCALE
DATE: OCTOBER 12, 2009

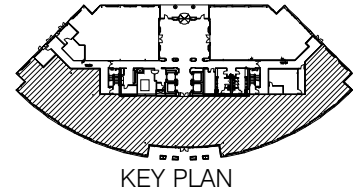

Bissell
DEVELOPMENT

 **SMITH
HARRIS
DESIGN**
associates