



SUITE 650  
AS BUILT - 1 OF 1  
HARRIS BUILDING - LEVEL SIX  
2,007 USF / 2,308 RSF  
SCALE: 1/8" = 1'-0"  
DATE: OCTOBER 12, 2009

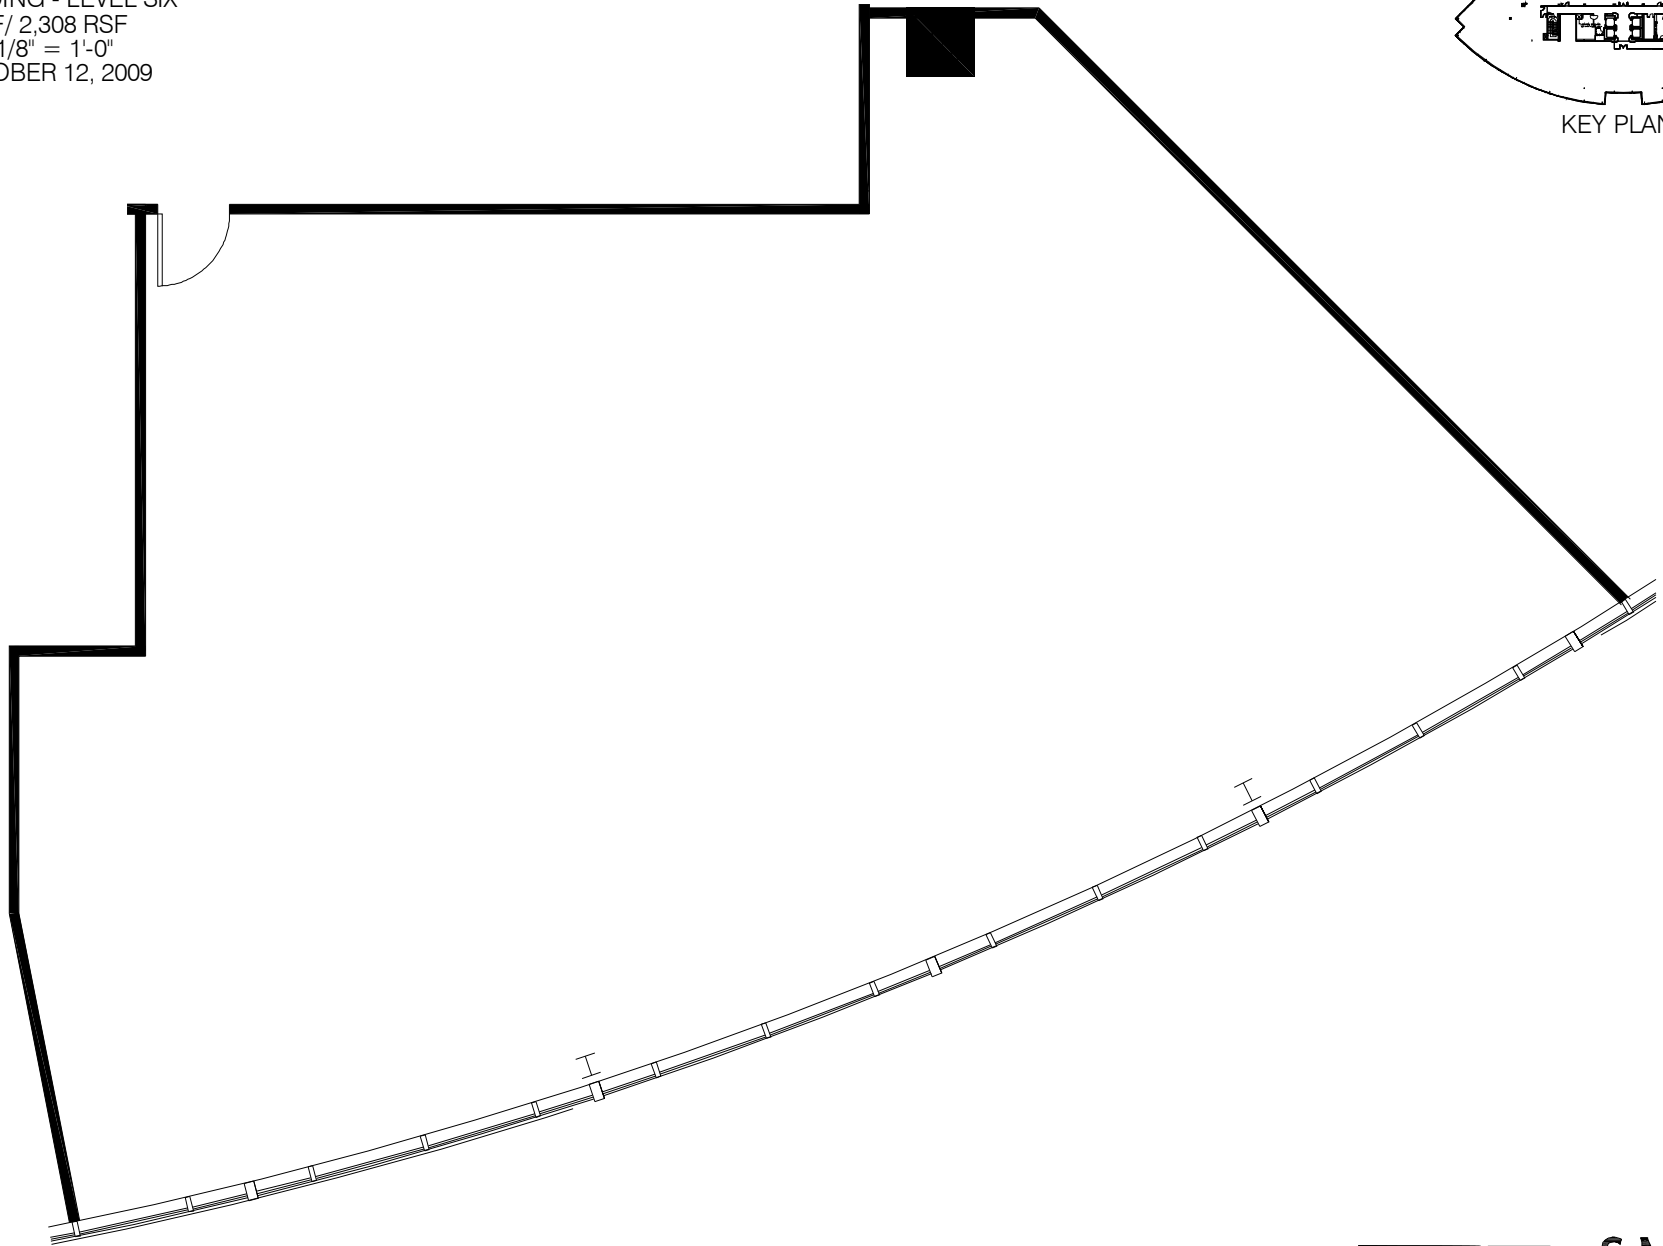

**Bissell**  
DEVELOPMENT

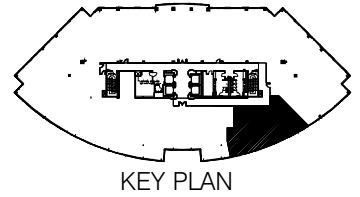

SMITH  
HARRIS  
DESIGN  
associates