



SUITE 100
AS BUILT - 1 OF 1
CORPORATE VILLA D - LEVEL ONE
700 USF
SCALE: 1/8" = 1'-0"
DATE: DECEMBER 3, 2009

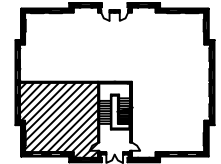

KEY PLAN

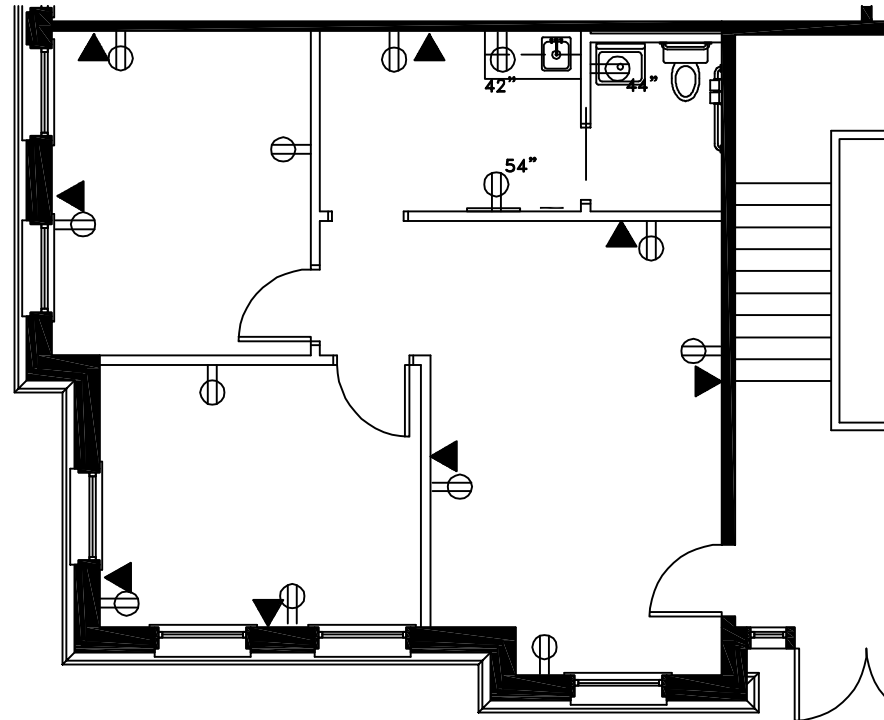

Bissell
DEVELOPMENT

**SMITH
HARRIS
DESIGN**
associates