

Hayes Building

11405 North
Community House Rd

Level
Four

As Built
Plan


6/16/2021

Not to Scale

NORTHWOOD
OFFICE



**SMITH
HARRIS**
DESIGN
associates

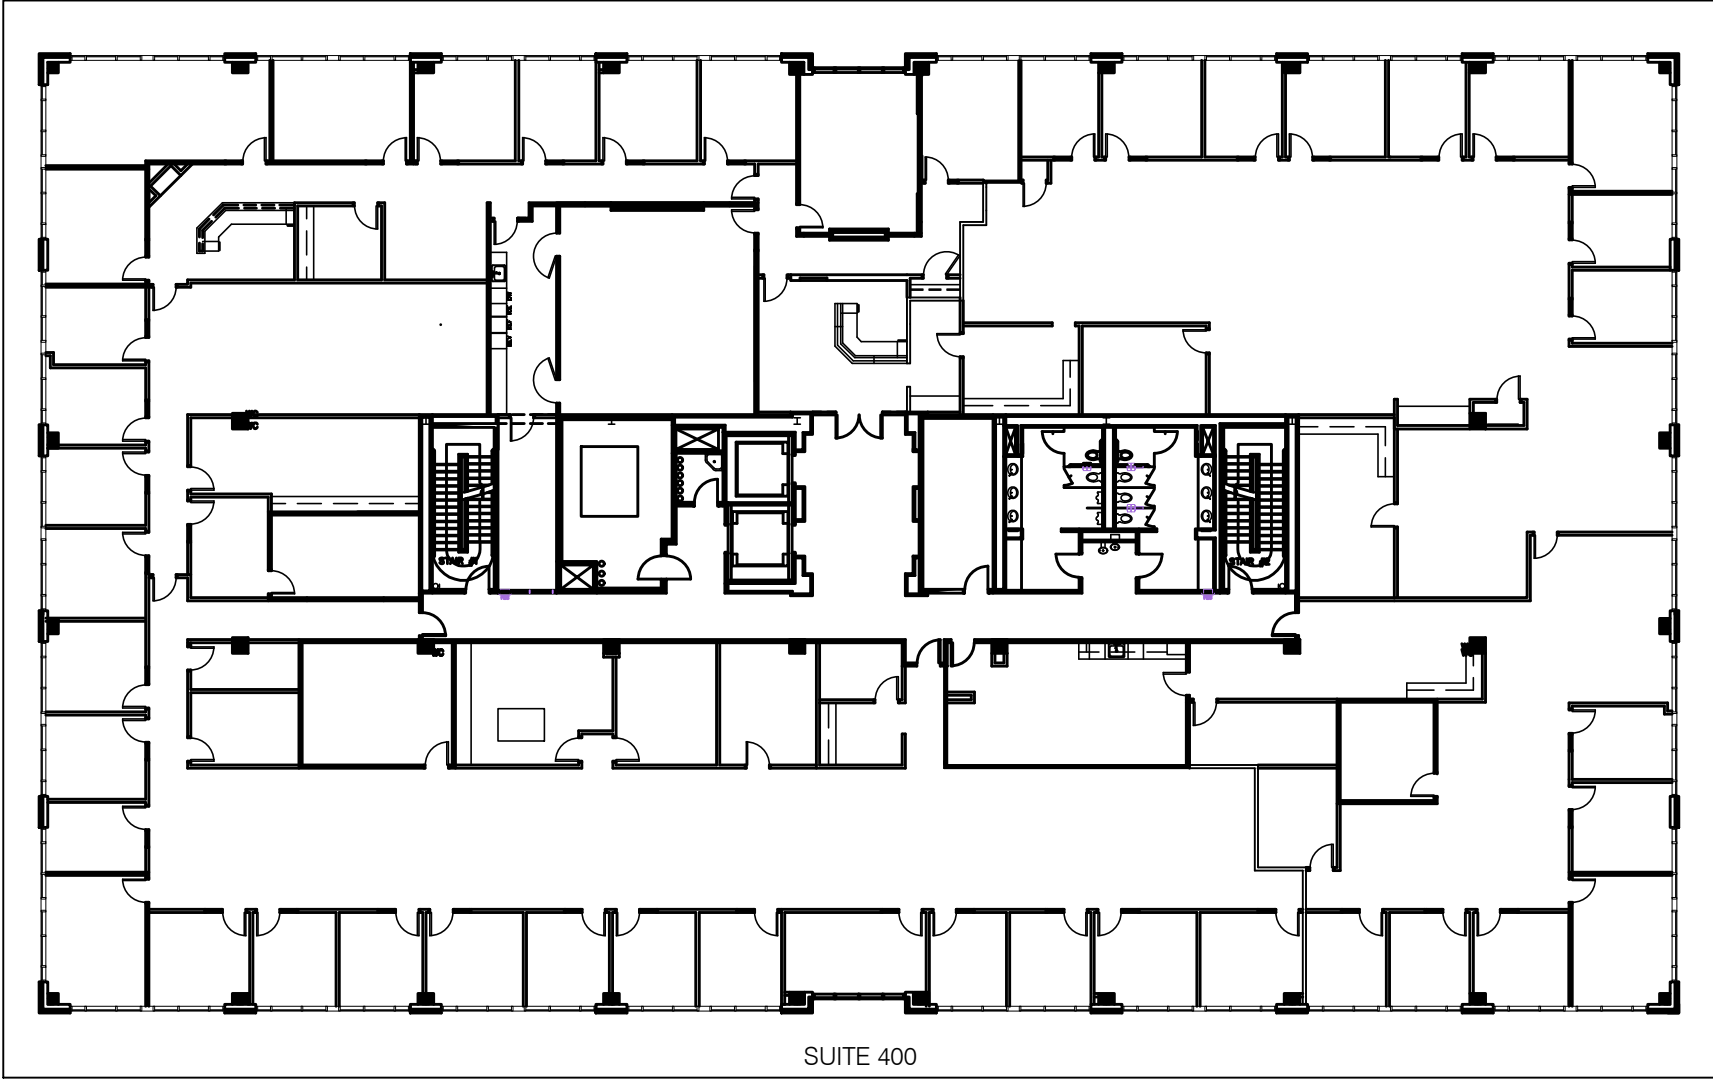

SUITE 400

23,811 USF / 26,430 RSF