
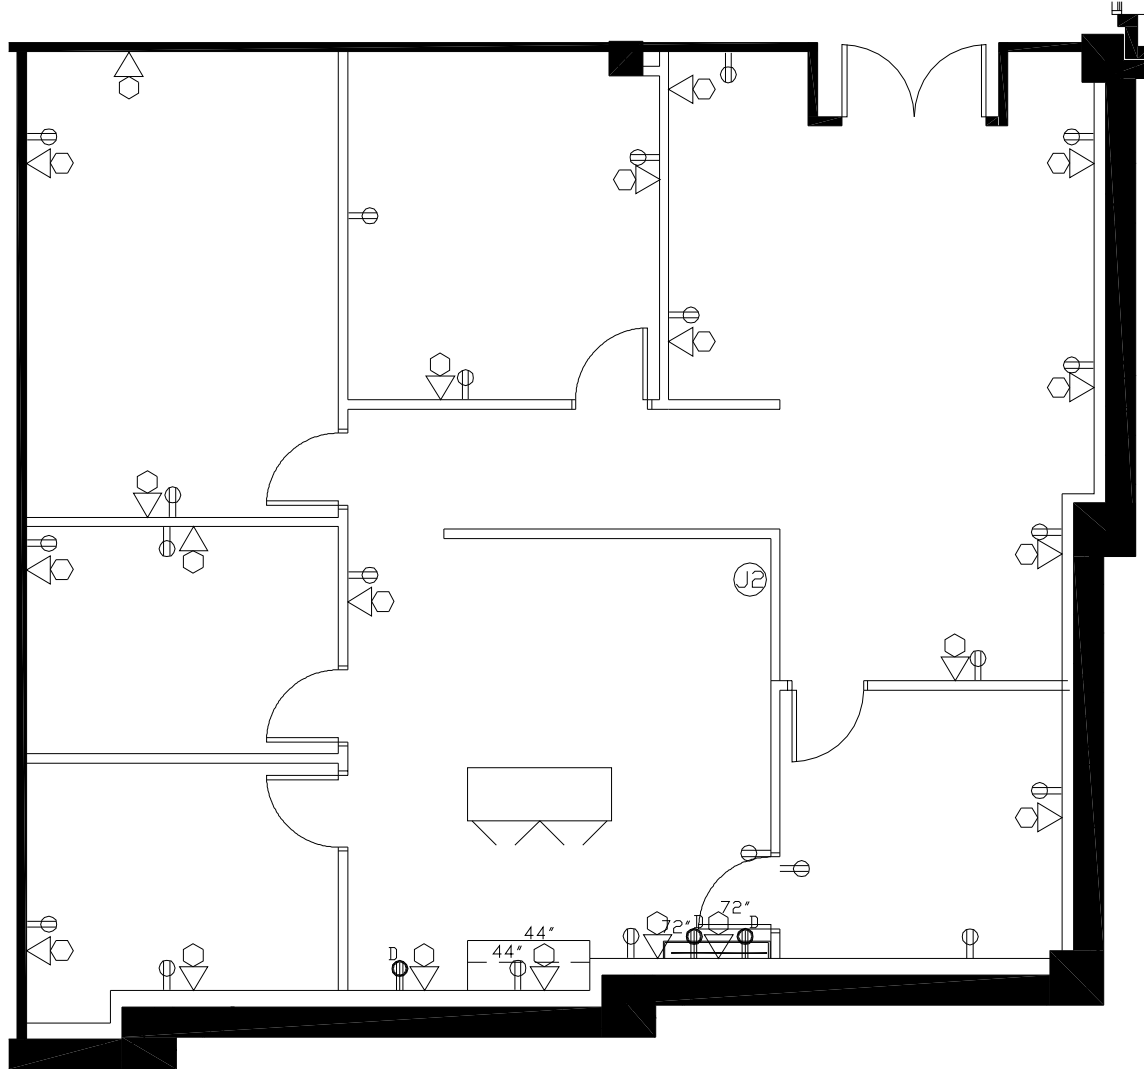


SUITE 140
AS BUILT - 1 OF 1
BALLANTYNE ONE - LEVEL ONE
1,730 USF / 1,990 RSF
SCALE: 1/8" = 1'-0"
DATE: MAY 11, 2010

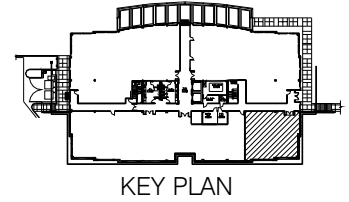

Bissell
DEVELOPMENT

**SMITH
HARRIS
DESIGN**
associates