



SUITE 550
 AS BUILT - 1 OF 1
 BRIXHAM GREEN II - LEVEL FIVE
 2,132 USF / 2,473 RSF
 SCALE: 1/8" = 1'-0"

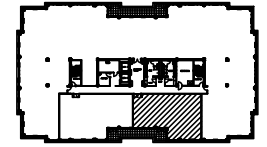

KEY PLAN

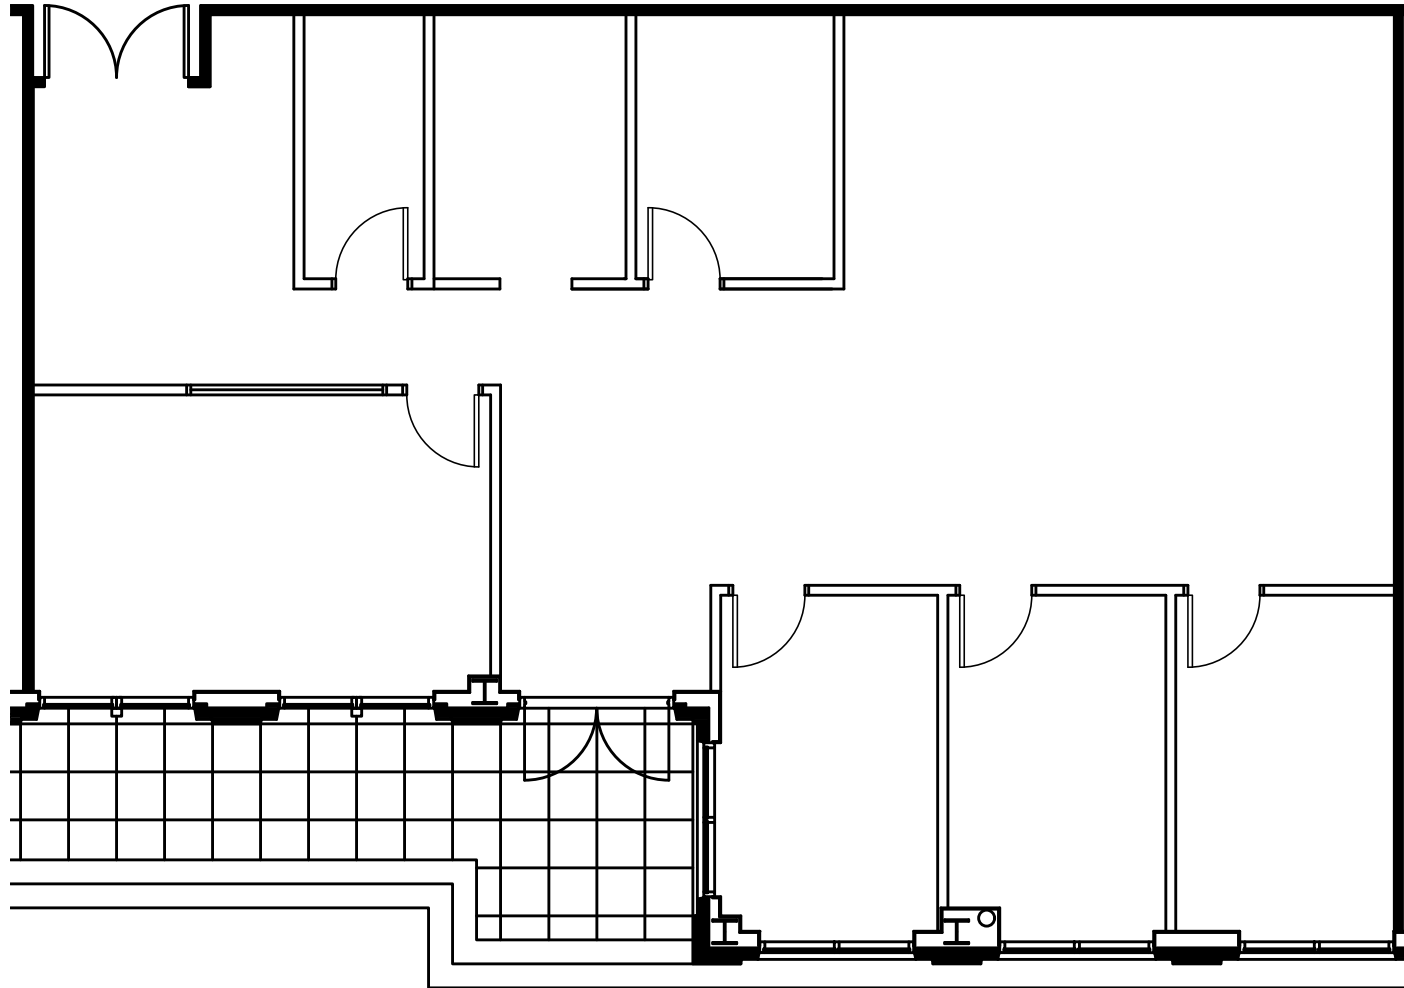

| SUMMARY | |
|---------|----------------|
| 1 | ENTRY |
| 1 | CONFERENCE |
| 1 | IT/STORAGE |
| 1 | WORK AREA |
| 4 | PRIVATE OFFICE |
| 1 | OPEN AREA |