




SUITE 120
AS BUILT - 1 OF 1
BALLANTYNE ONE - LEVEL ONE
4,519 USF / 5,242 RSF
SCALE: 3/32" = 1'-0"
DATE: JULY 2, 2019

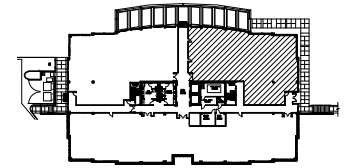

KEY PLAN

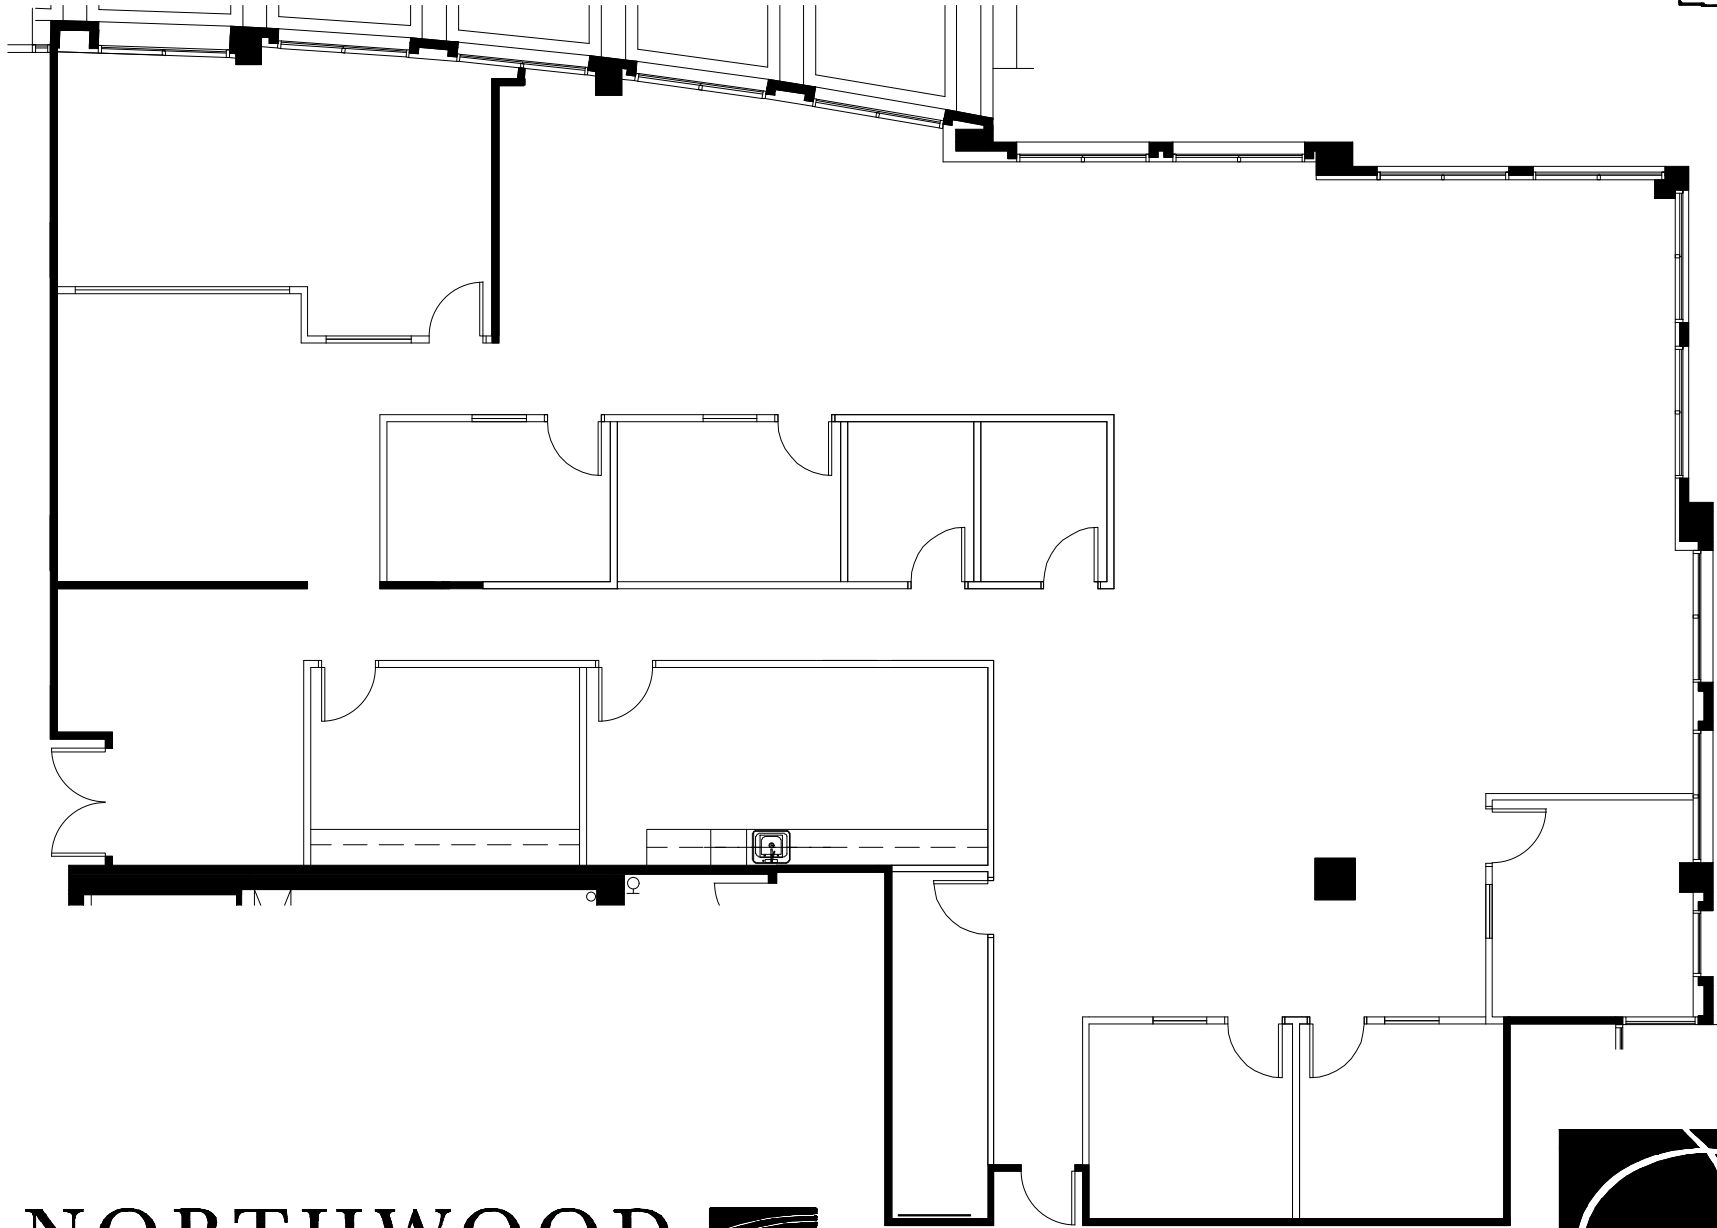

NORTHWOOD
OFFICE

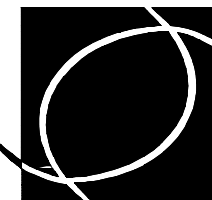

**SMITH
HARRIS**
DESIGN
associates