


SUITE 145
 AS BUILT - 1 OF 1
 BALLANTYNE ONE - LEVEL ONE
 1,024 USF / 1,188 RSF
 SCALE: 1/8" = 1'-0"
 DATE: JANUARY 7, 2021



SUMMARY	
1	RECEPTION
1	OPEN AREA
2	PRIVATE OFFICE
1	STORAGE
1	WORK ROOM

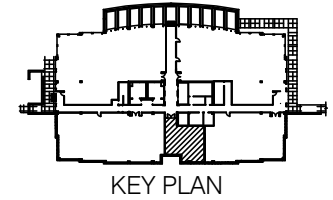