



SUITE 525
AS BUILT - 1 OF 1
BALLANTYNE ONE - LEVEL FIVE
3,161 USF / 3,667 RSF
SCALE: 3/32" = 1'-0"
DATE: AUGUST 21, 2019

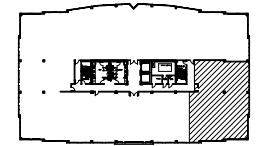

KEY PLAN

NORTHWOOD
OFFICE

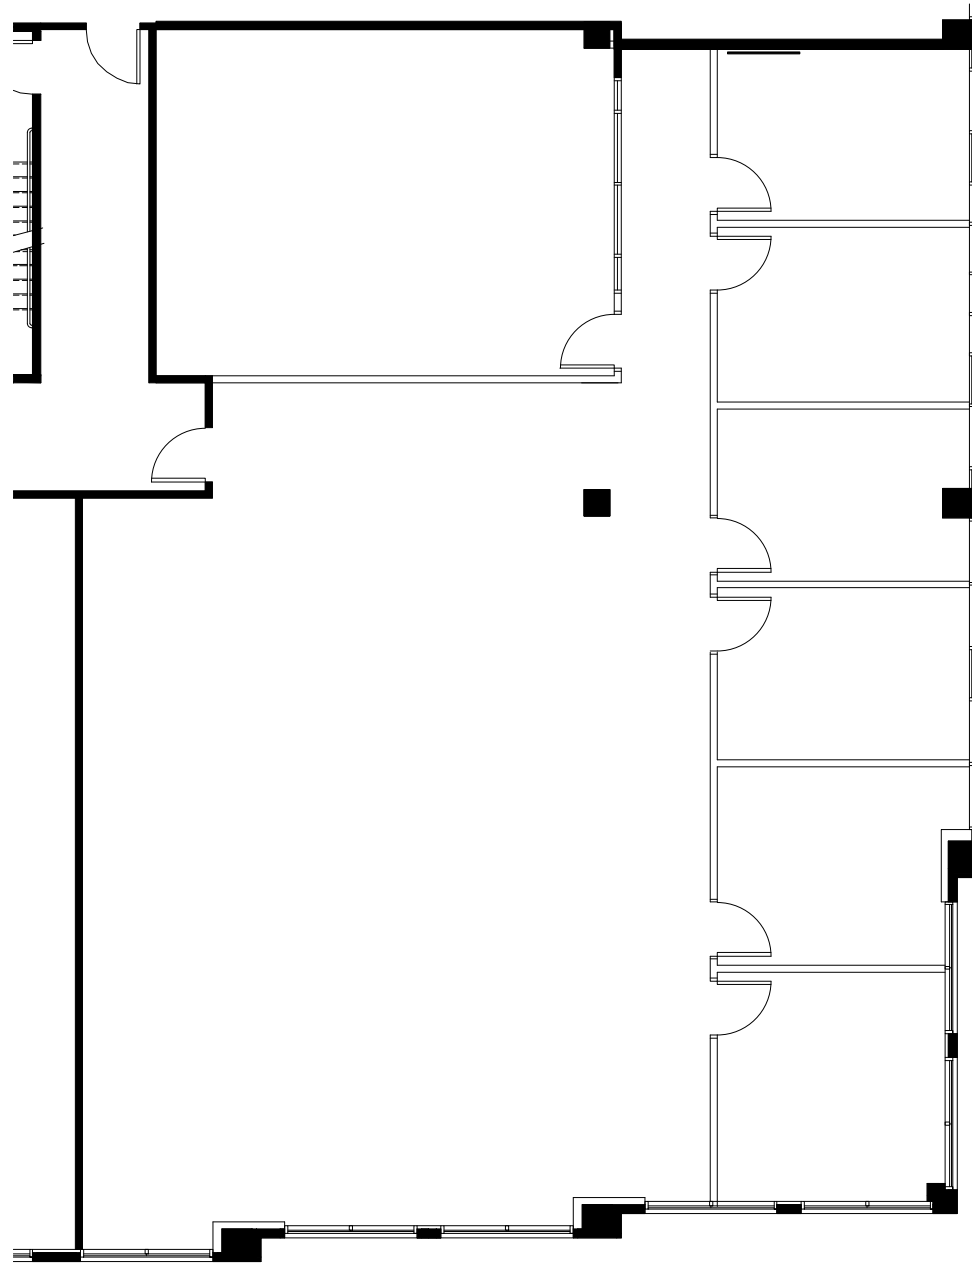

**SMITH
HARRIS**
DESIGN
associates