


SUITE 100
3,090 RSF

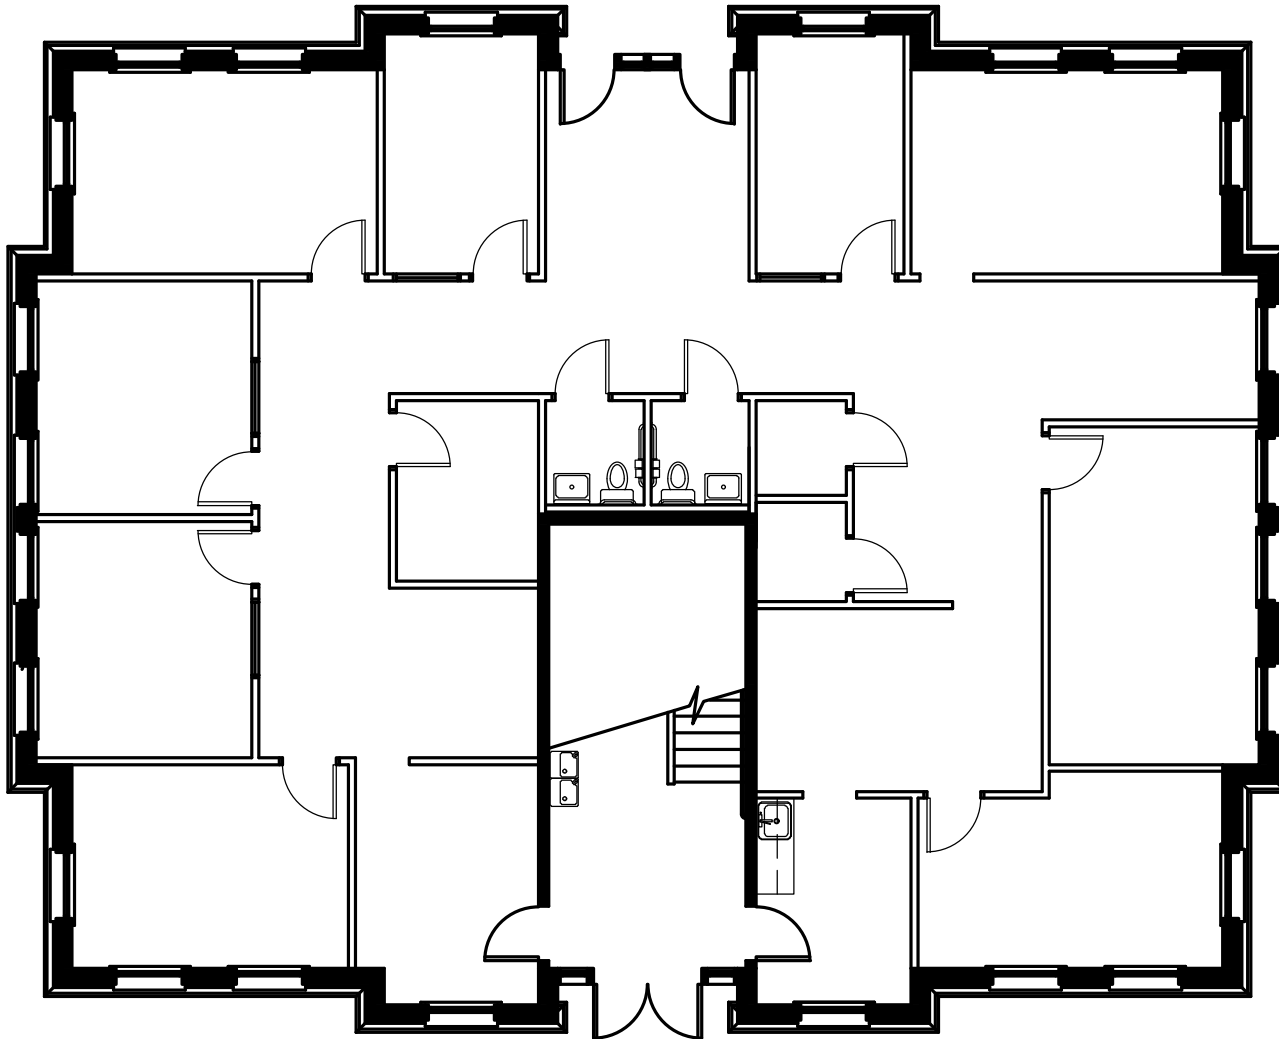

Offices On Six

North Community
House Road

Building F

Level
One

As Built

June 30, 2020

Not to Scale

NORTHWOOD
OFFICES



**SMITH
HARRIS**
DESIGN
associates