




SUITE 320  
AS BUILT - 1 OF 1  
BRIXHAM GREEN ONE - LEVEL THREE  
3,083 USF / 3,576 RSF  
SCALE: 3/32" = 1'-0"  
DATE: AUGUST 28, 2018

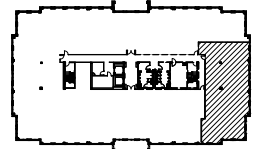

KEY PLAN

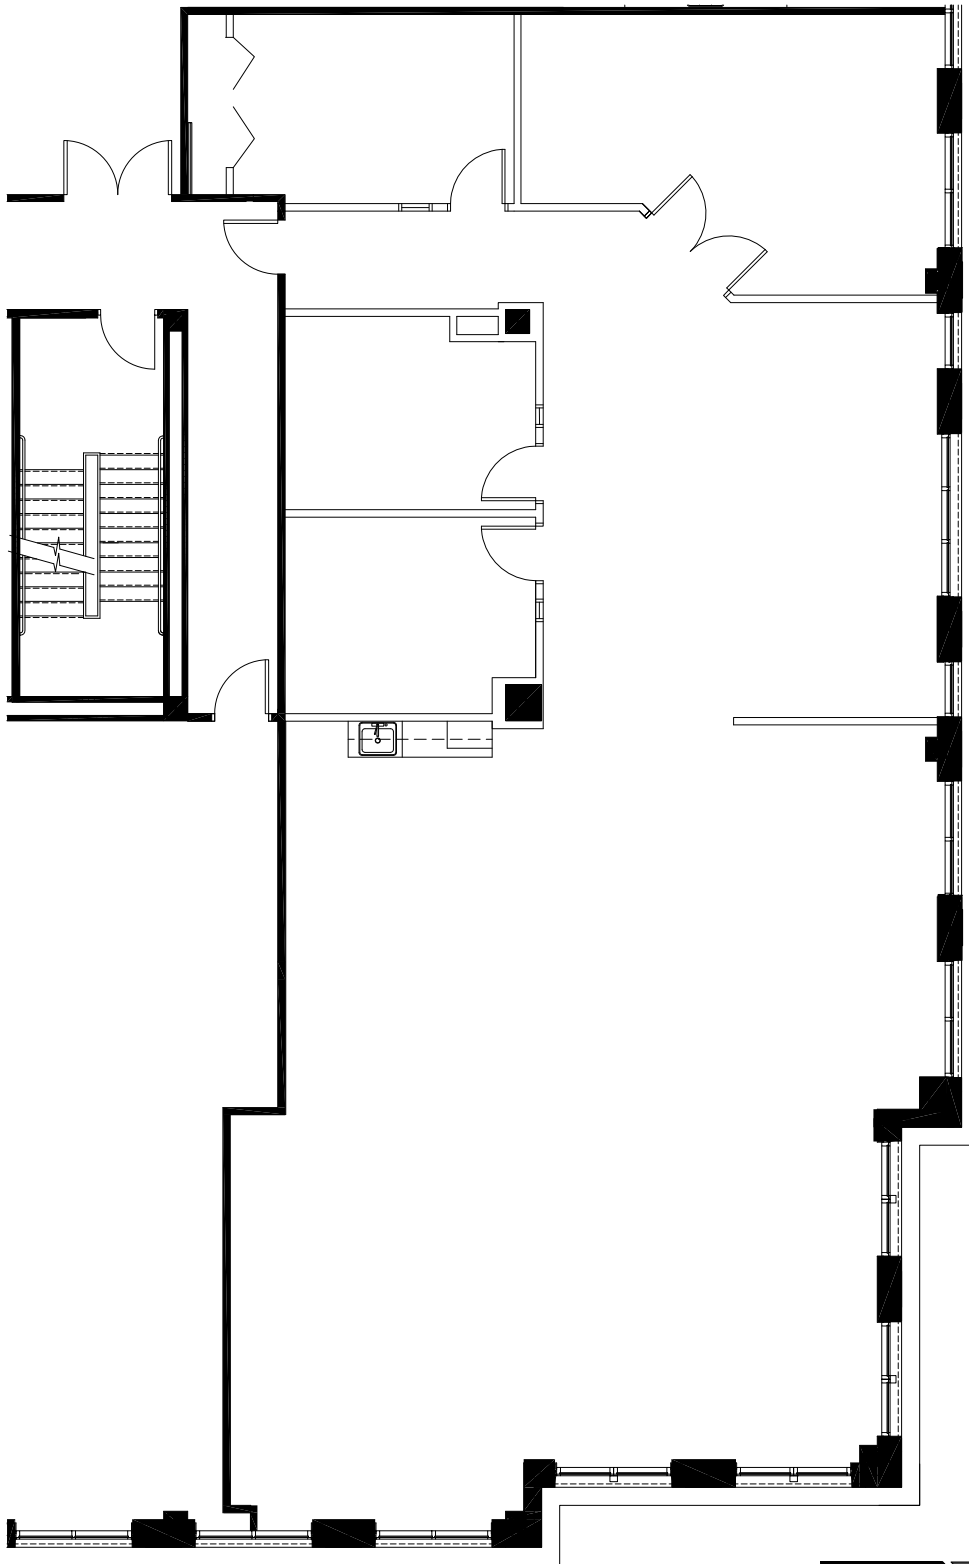

**NORTHWOOD**  
OFFICE

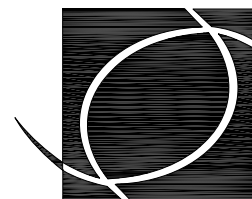

**SMITH  
HARRIS  
DESIGN**  
associates