





SUITE 430
AS BUILT - 1 OF 1
BRIXHAM GREEN ONE - LEVEL FOUR
2,870 USF / 3,300 RSF
SCALE: 3/32" = 1'-0"
DATE: APRIL 4, 2017

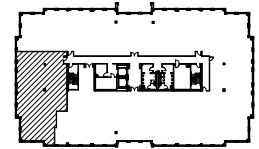

KEY PLAN

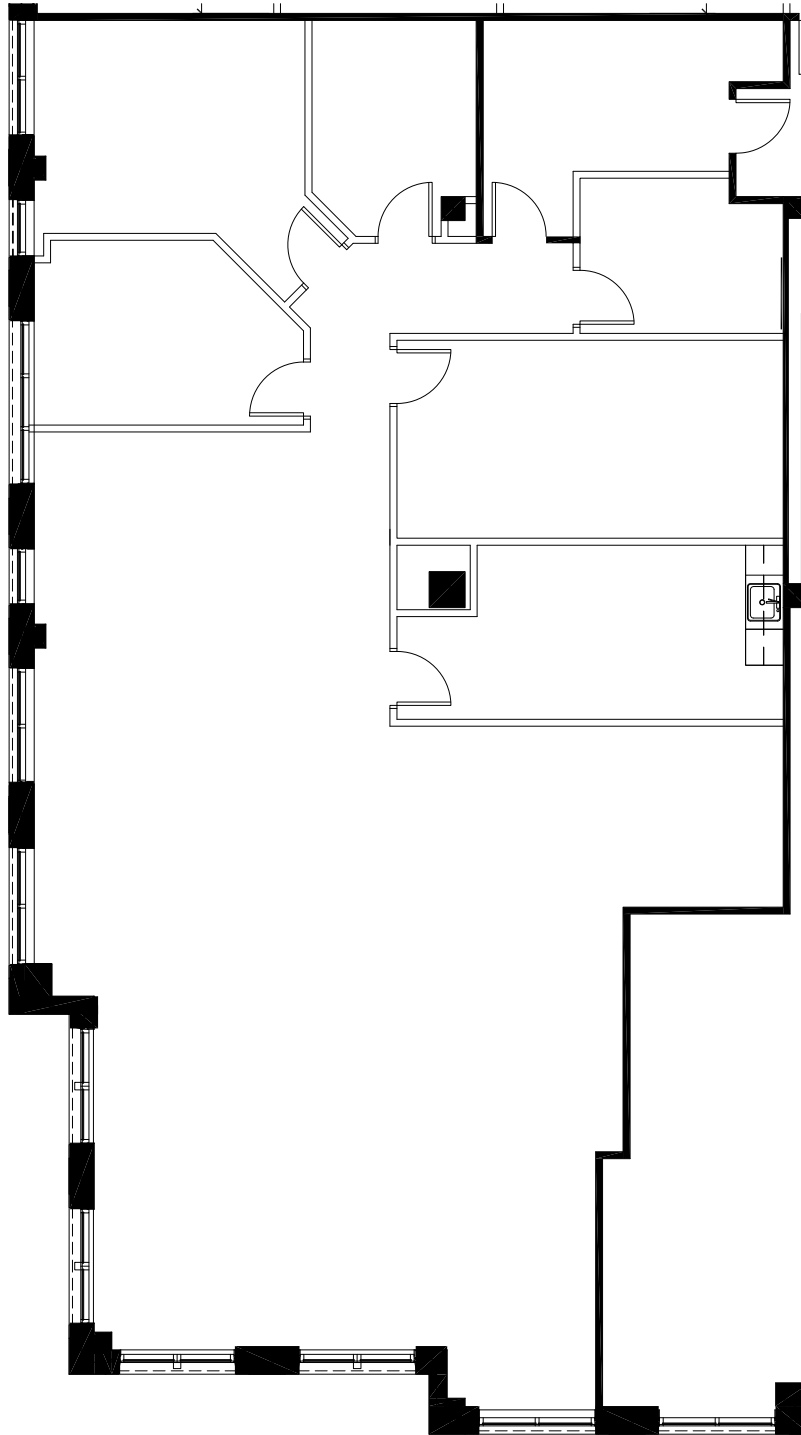

NORTHWOOD
OFFICE

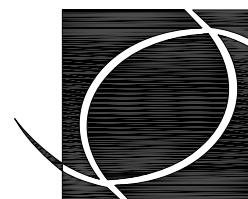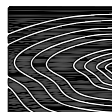

**SMITH
HARRIS**
DESIGN
associates