




SUITE 550
AS-BUILT - 1 OF 1
BRIXHAM GREEN ONE
5,190 USF / 6,020 RSF
SCALE: 1/16" = 1'-0"
DATE: JUNE 27, 2019

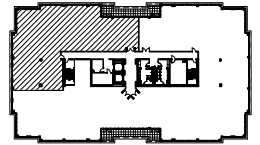

KEY PLAN

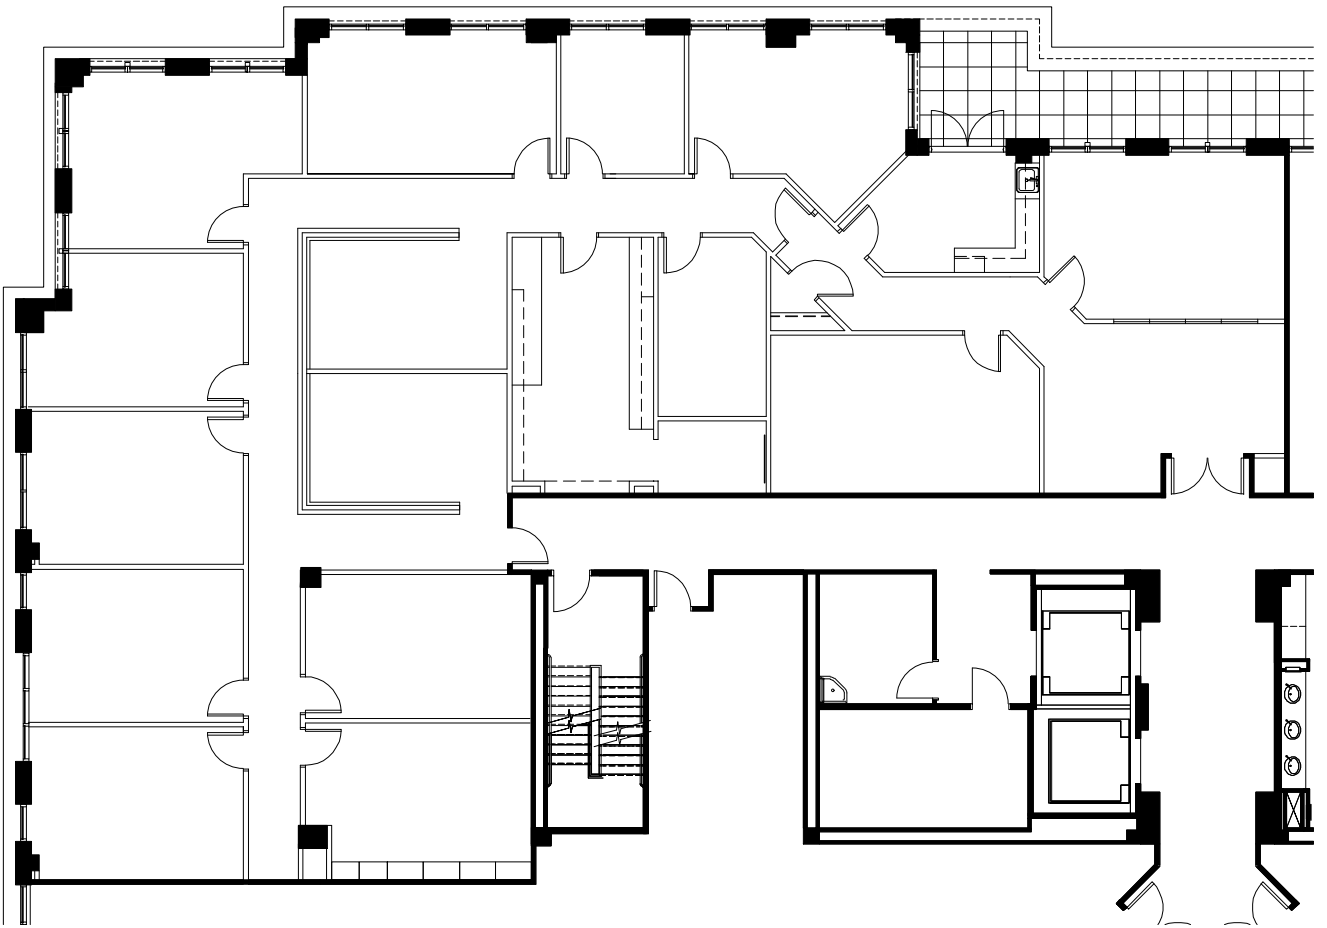

NORTHWOOD
OFFICE

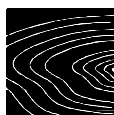

**SMITH
HARRIS**
DESIGN
associates