




SUITE 400
AS BUILT - 1 OF 1
CULLMAN PARK - LEVEL FOUR
7,161 RSF
SCALE: NOT TO SCALE
DATE: OCTOBER 1, 2018

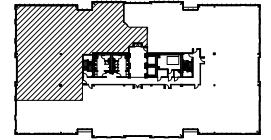

KEY PLAN

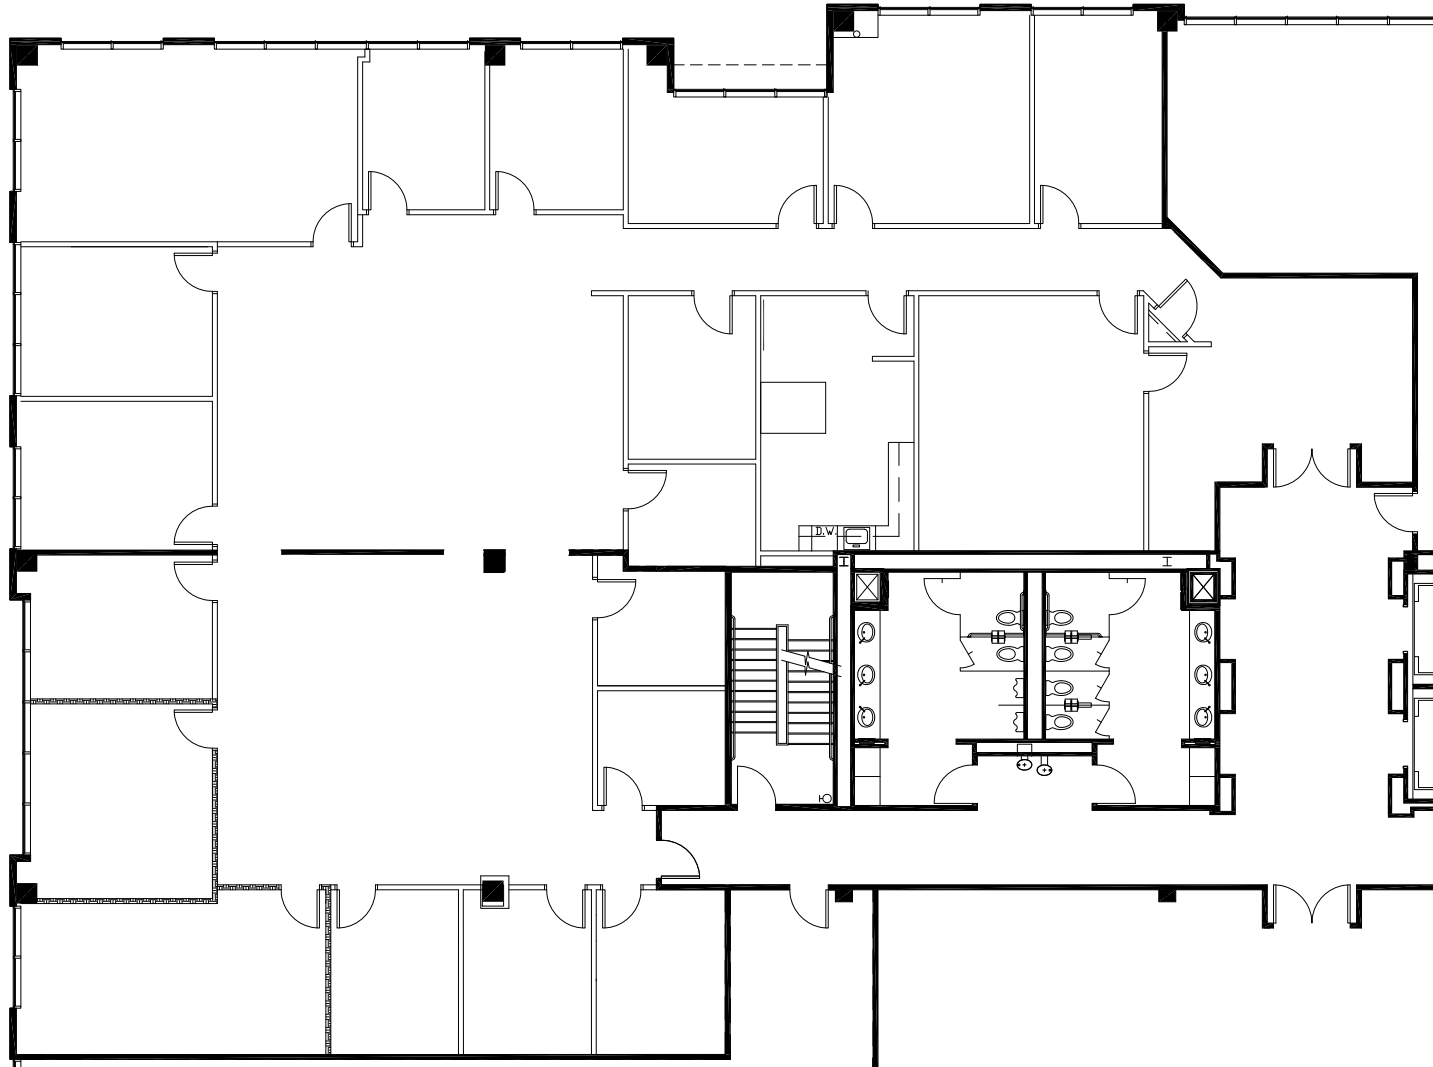

NORTHWOOD
OFFICE

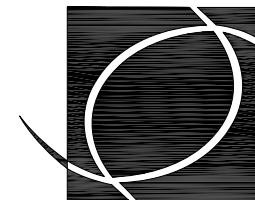

**SMITH
HARRIS**
DESIGN
associates