


SUITE 160
AS BUILT - 1 OF 1
CURRAN - LEVEL ONE
1,250 RSF
SCALE: 1/8" = 1'-0"
DATE: JULY 9, 2020

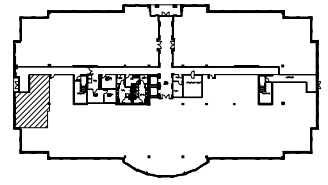

KEY PLAN

