




SUITE 550
AS BUILT - 1 OF 1
EVERETT BUILDING - LEVEL FIVE
8,128 USF / 9,428 RSF
NOT TO SCALE
DATE: JULY 8, 2019

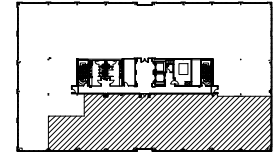

KEY PLAN

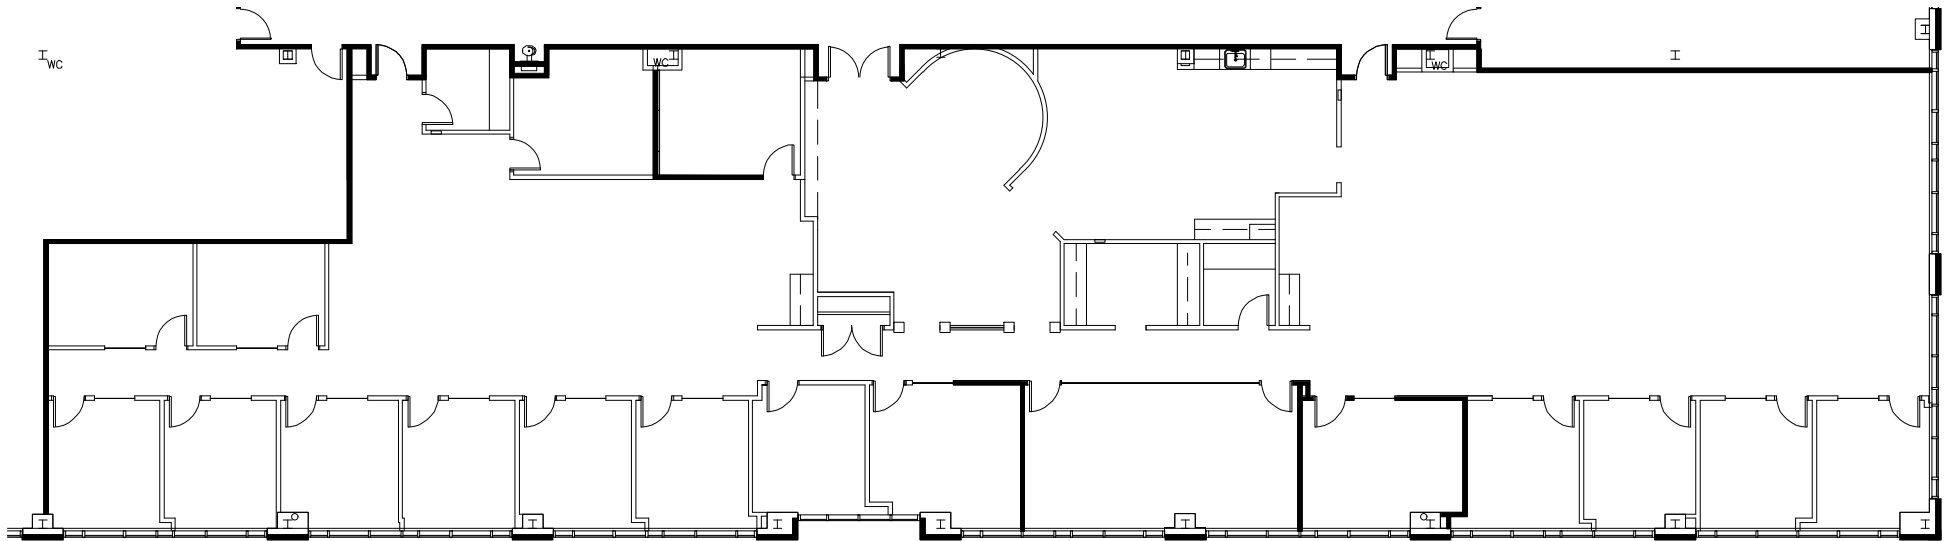

NORTHWOOD
OFFICE

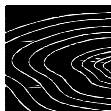

**SMITH
HARRIS**
DESIGN
associates