



SUITE 150
AS BUILT - 1 OF 1
HALL BUILDING - LEVEL ONE
5,012 USF/ 5,814 RSF
NOT TO SCALE

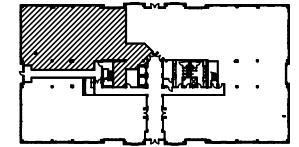

KEY PLAN

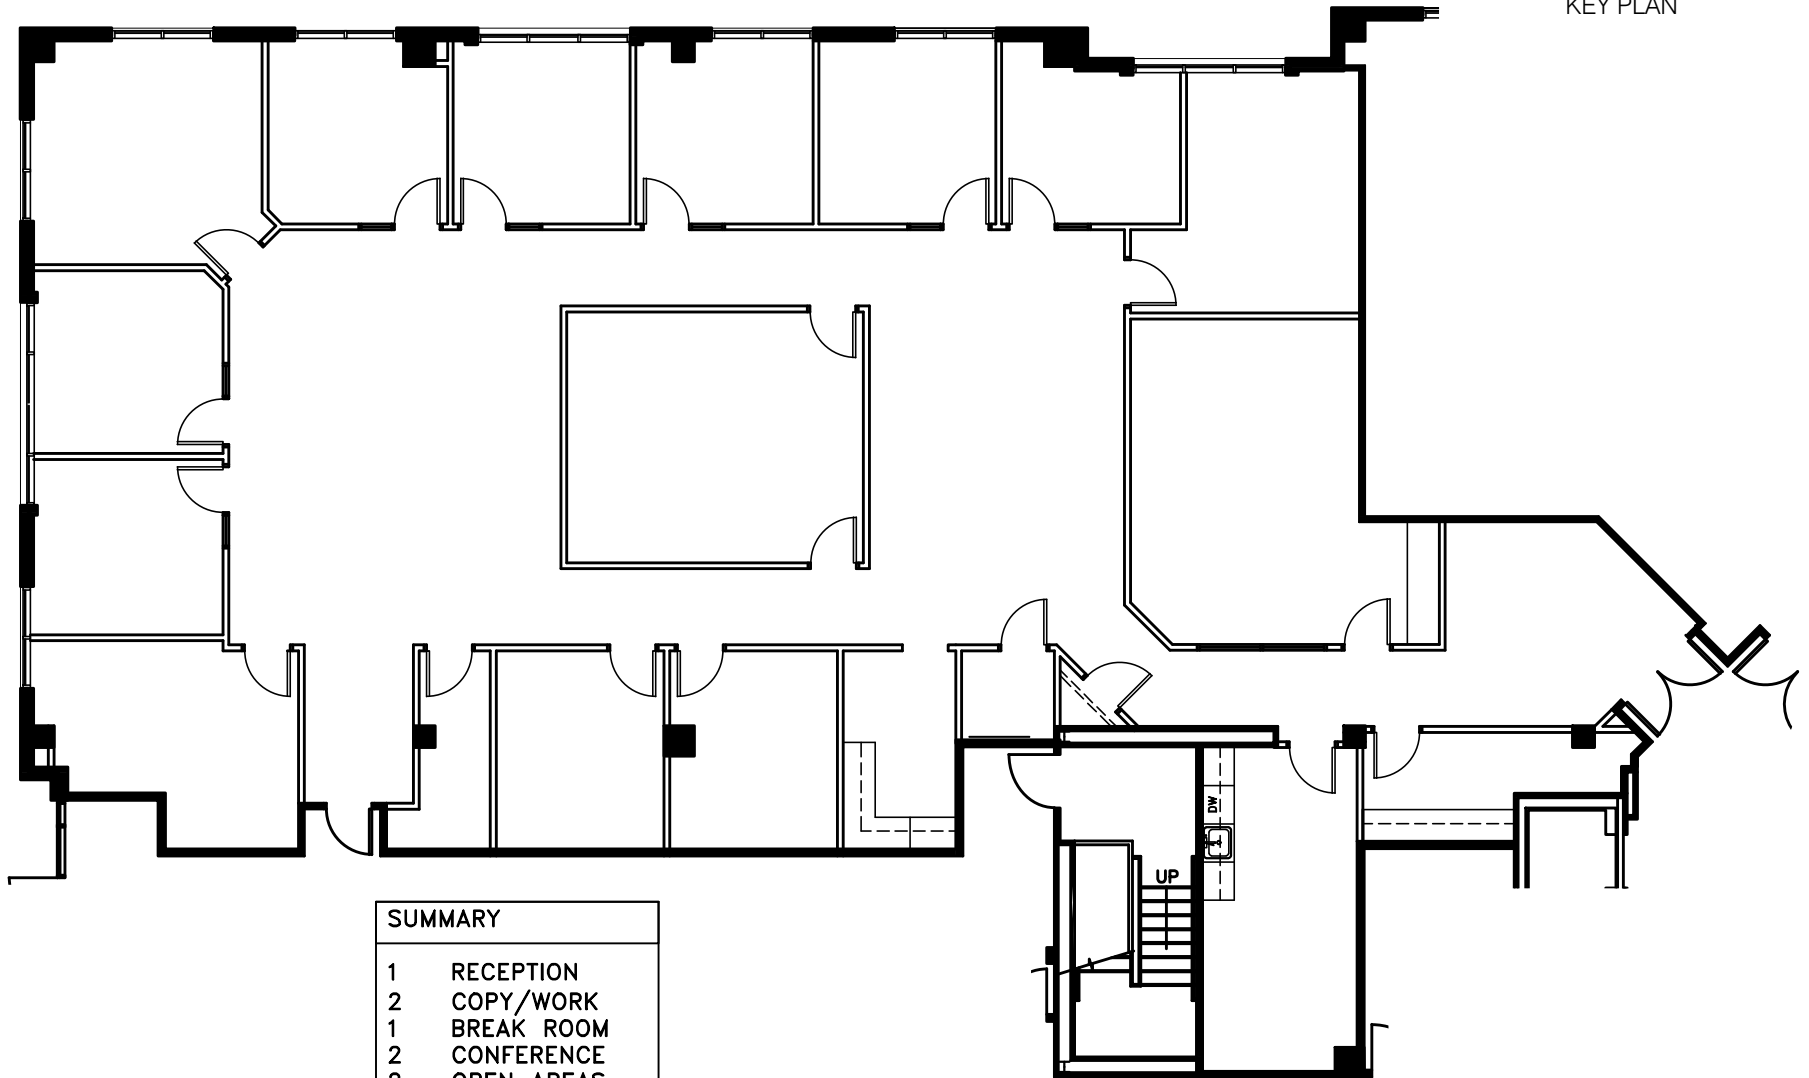

SUMMARY	
1	RECEPTION
2	COPY/WORK
1	BREAK ROOM
2	CONFERENCE
2	OPEN AREAS
1	IT
2	STORAGE
12	PRIVATE OFFICE