




SUITE 125  
AS BUILT - 1 OF 1  
IRBY BUILDING - LEVEL ONE  
2,602 USF / 3,018 RSF  
SCALE: 3/32" = 1'-0"  
DATE: JANUARY 25, 2019

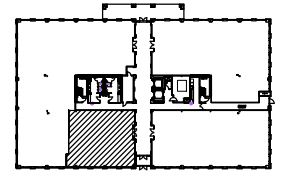

KEY PLAN

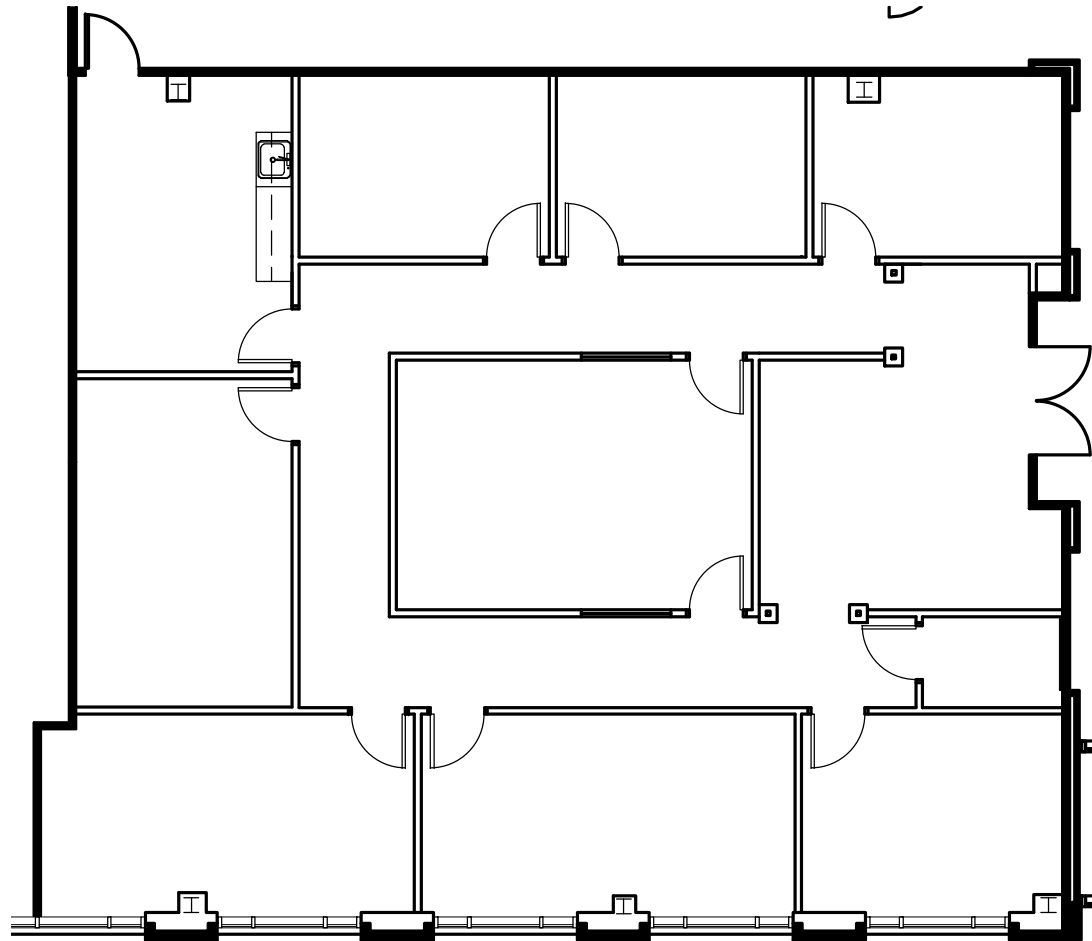

**NORTHWOOD**  
OFFICE

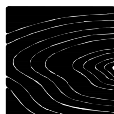

**SMITH  
HARRIS**  
**DESIGN**  
associates