




SUITE 125
AS BUILT - 1 OF 1
IRBY BUILDING - LEVEL ONE
2,602 USF / 3,018 RSF
SCALE: 3/32" = 1'-0"
DATE: JANUARY 25, 2019

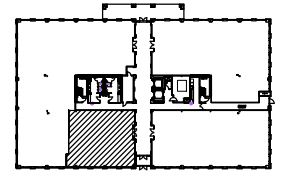

KEY PLAN

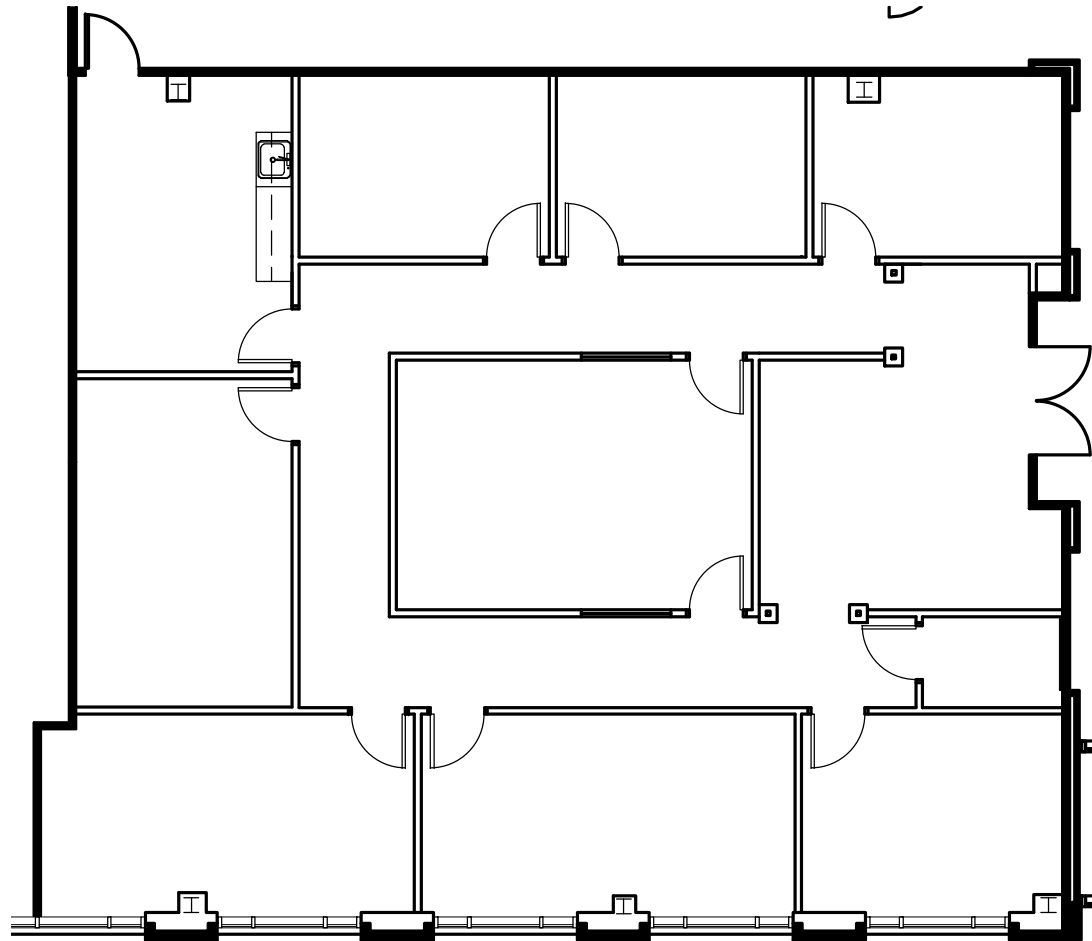

NORTHWOOD
OFFICE

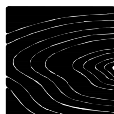

**SMITH
HARRIS**
DESIGN
associates