



SUITE 625
AS BUILT - 1 OF 1
IRBY BUILDING - LEVEL SIX
3,380 USF / 3,921 RSF
SCALE: 3/32" = 1'-0"
DATE: JULY 20, 2020

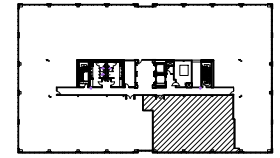

KEY PLAN

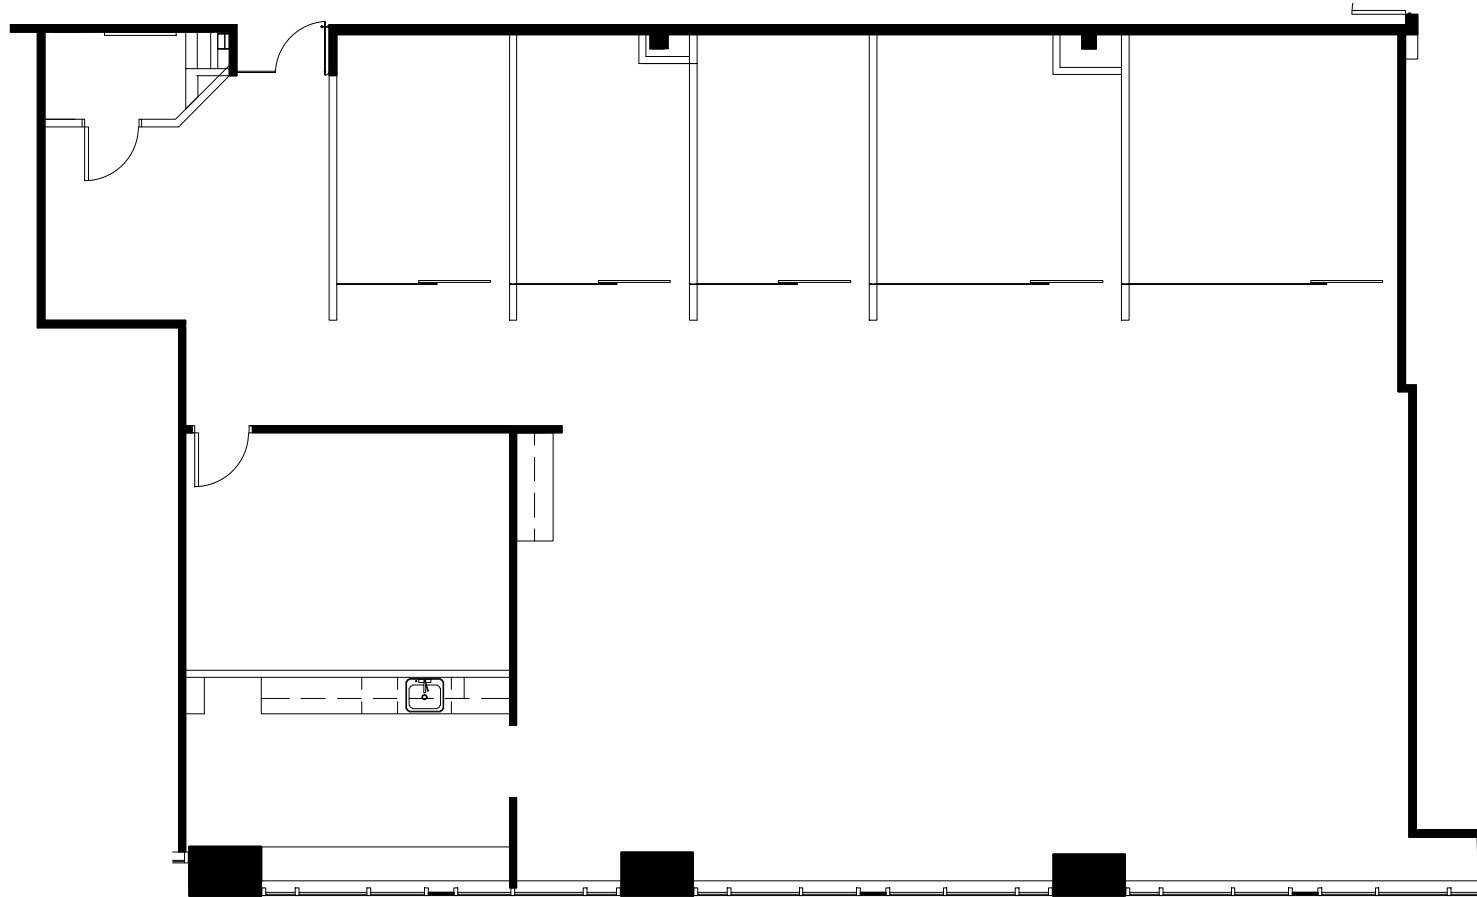

NORTHWOOD
OFFICE



**SMITH
HARRIS**
DESIGN
associates