


SUITE 160
AS BUILT - 1 OF 1
RICHARDSON - LEVEL ONE
1,078 USF / 1,250 RSF
SCALE: 1/8" = 1'-0"
DATE: AUGUST 1, 2019

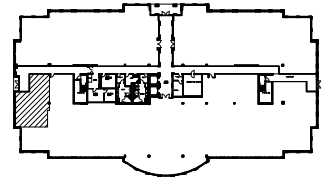

KEY PLAN

