




SUITE 120  
AS BUILT - 1 OF 1  
BALLANTYNE ONE - LEVEL ONE  
4,519 USF / 5,242 RSF  
SCALE: 3/32" = 1'-0"  
DATE: JUNE 3, 2021

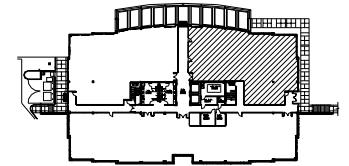

KEY PLAN

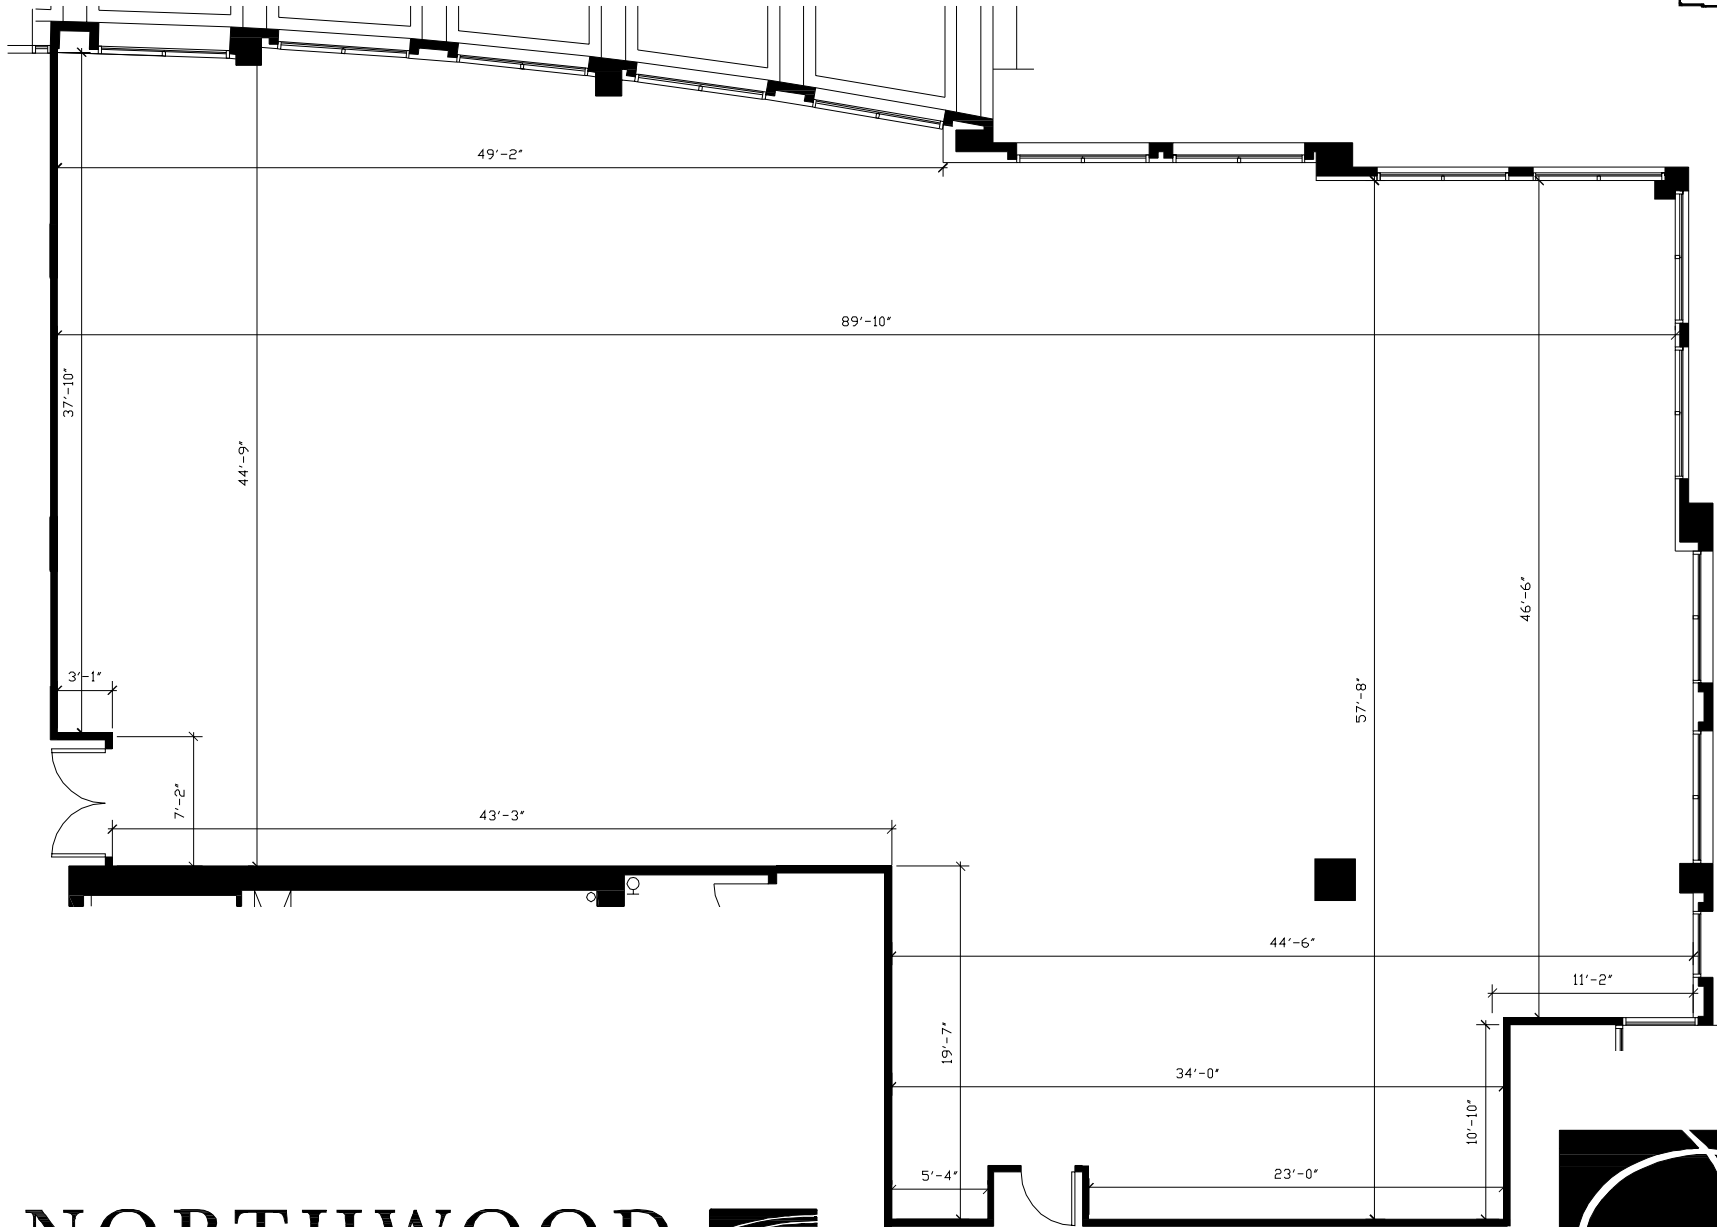

**NORTHWOOD**  
OFFICE

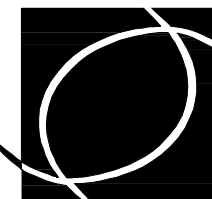

**SMITH  
HARRIS**  
**DESIGN**  
associates