



SUITE 150
 AS BUILT - 1 OF 1
 IRBY BUILDING - LEVEL ONE
 2,323 USF / 2,695 RSF
 SCALE: 1/8" = 1'-0"
 DATE: OCTOBER 5, 2021

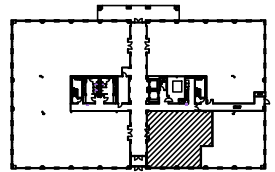

KEY PLAN

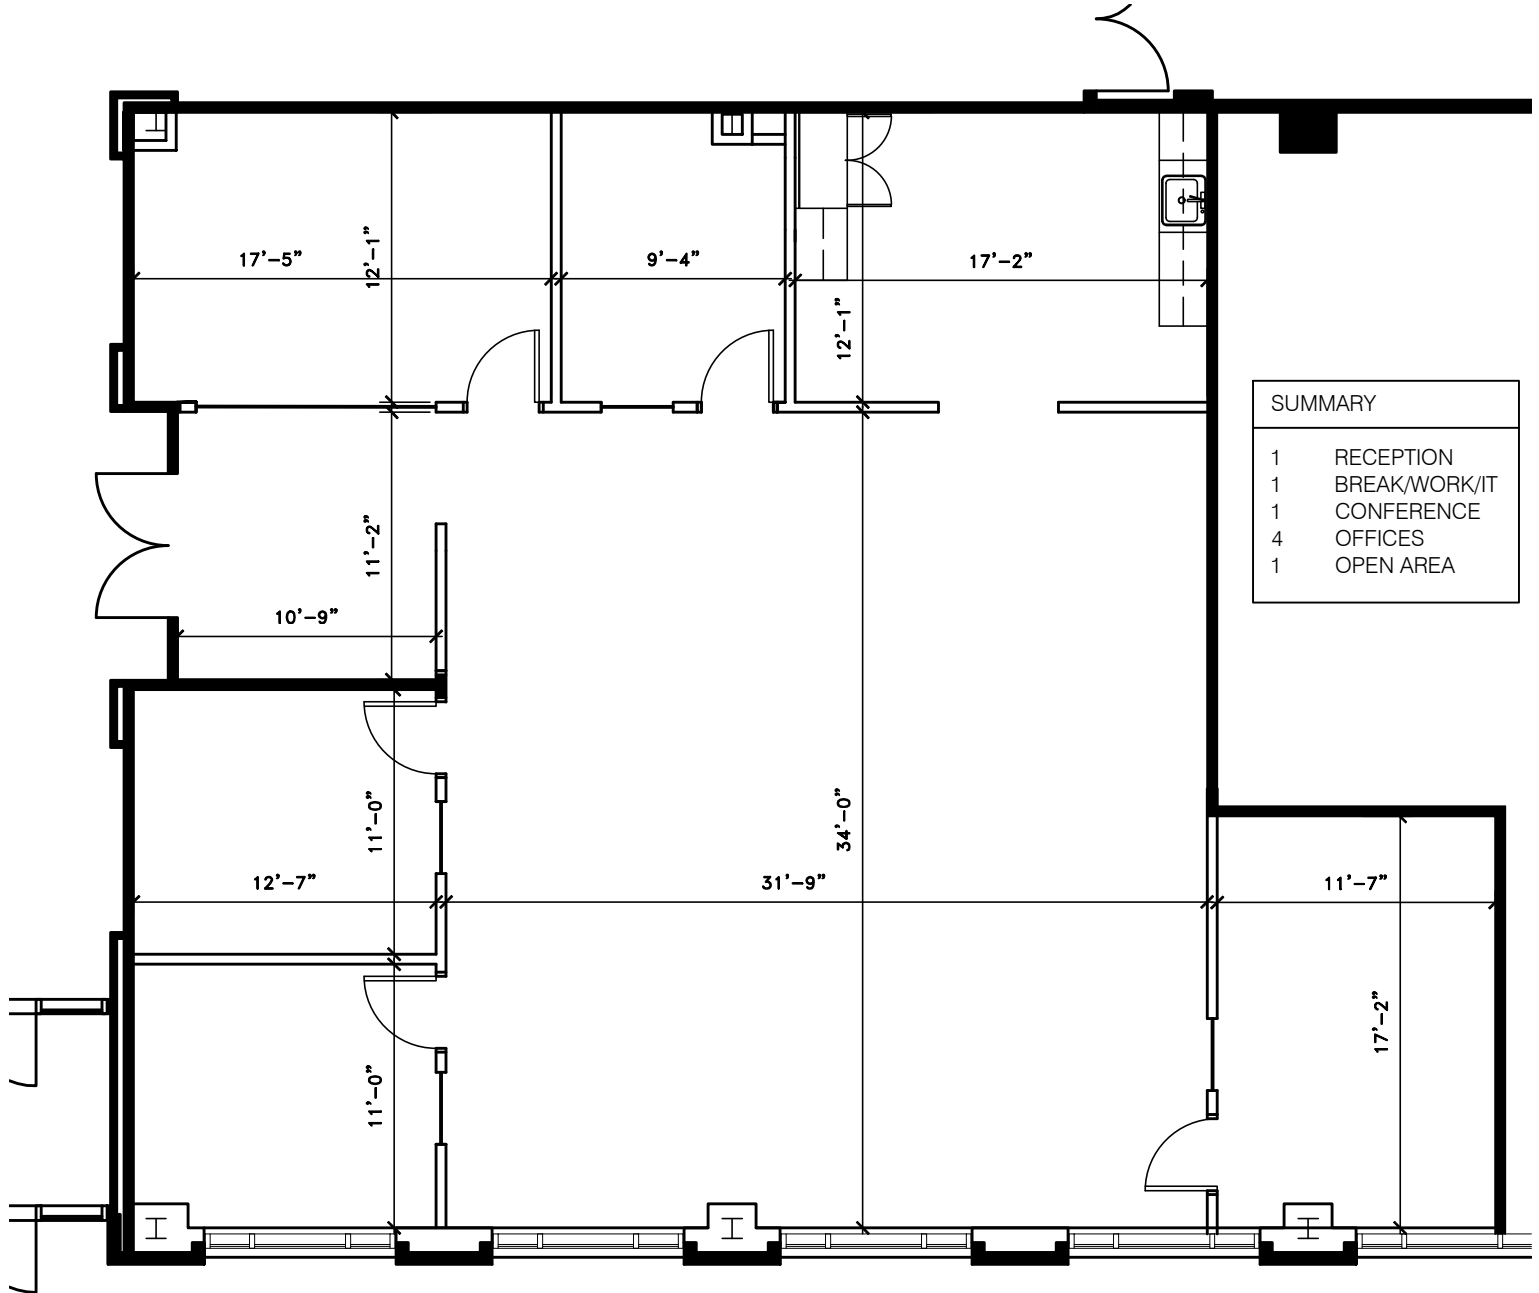

SUMMARY	
1	RECEPTION
1	BREAK/WORK/IT
1	CONFERENCE
4	OFFICES
1	OPEN AREA