



SUITE 210  
 AS BUILT PLAN - 1 OF 1  
 HALL BUILDING - LEVEL TWO  
 1,397 USF/ 1,621 RSF  
 SCALE: 1/8" = 1'-0"  
 DATE: JULY 7, 2021


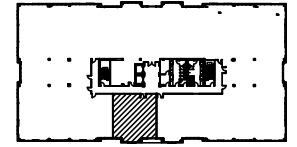


KEY PLAN

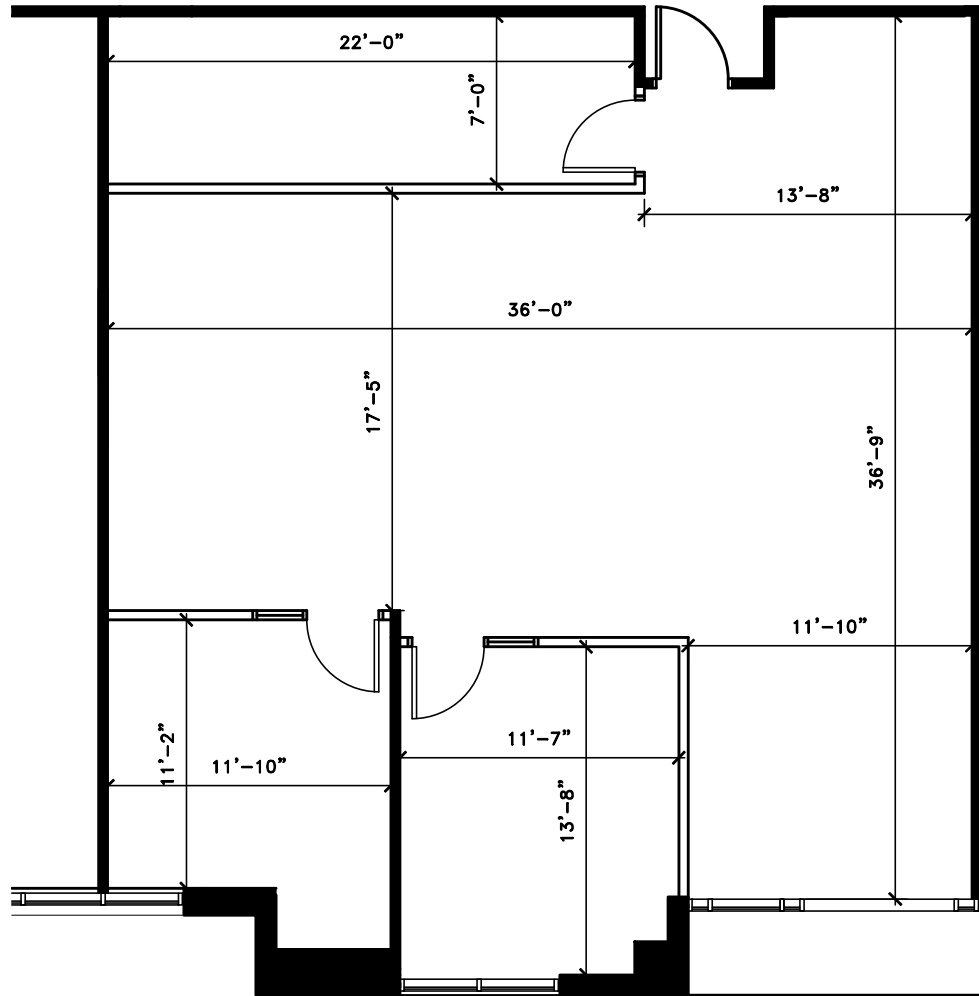

SUMMARY	
1	ENTRY
1	IT/STORAGE
1	OPEN AREA
2	PRIVATE OFFICE

**NORTHWOOD**  
 OFFICE

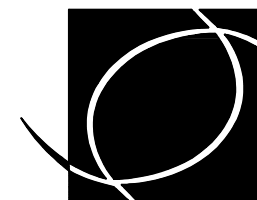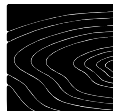

**SMITH  
 HARRIS**  
 DESIGN  
 associates