




SUITE 225  
AS BUILT - 1 OF 1  
CRAWFORD BUILDING - LEVEL TWO  
6,885 RSF  
NOT TO SCALE  
DATE: OCTOBER 15, 2018

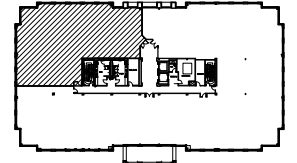

KEY PLAN

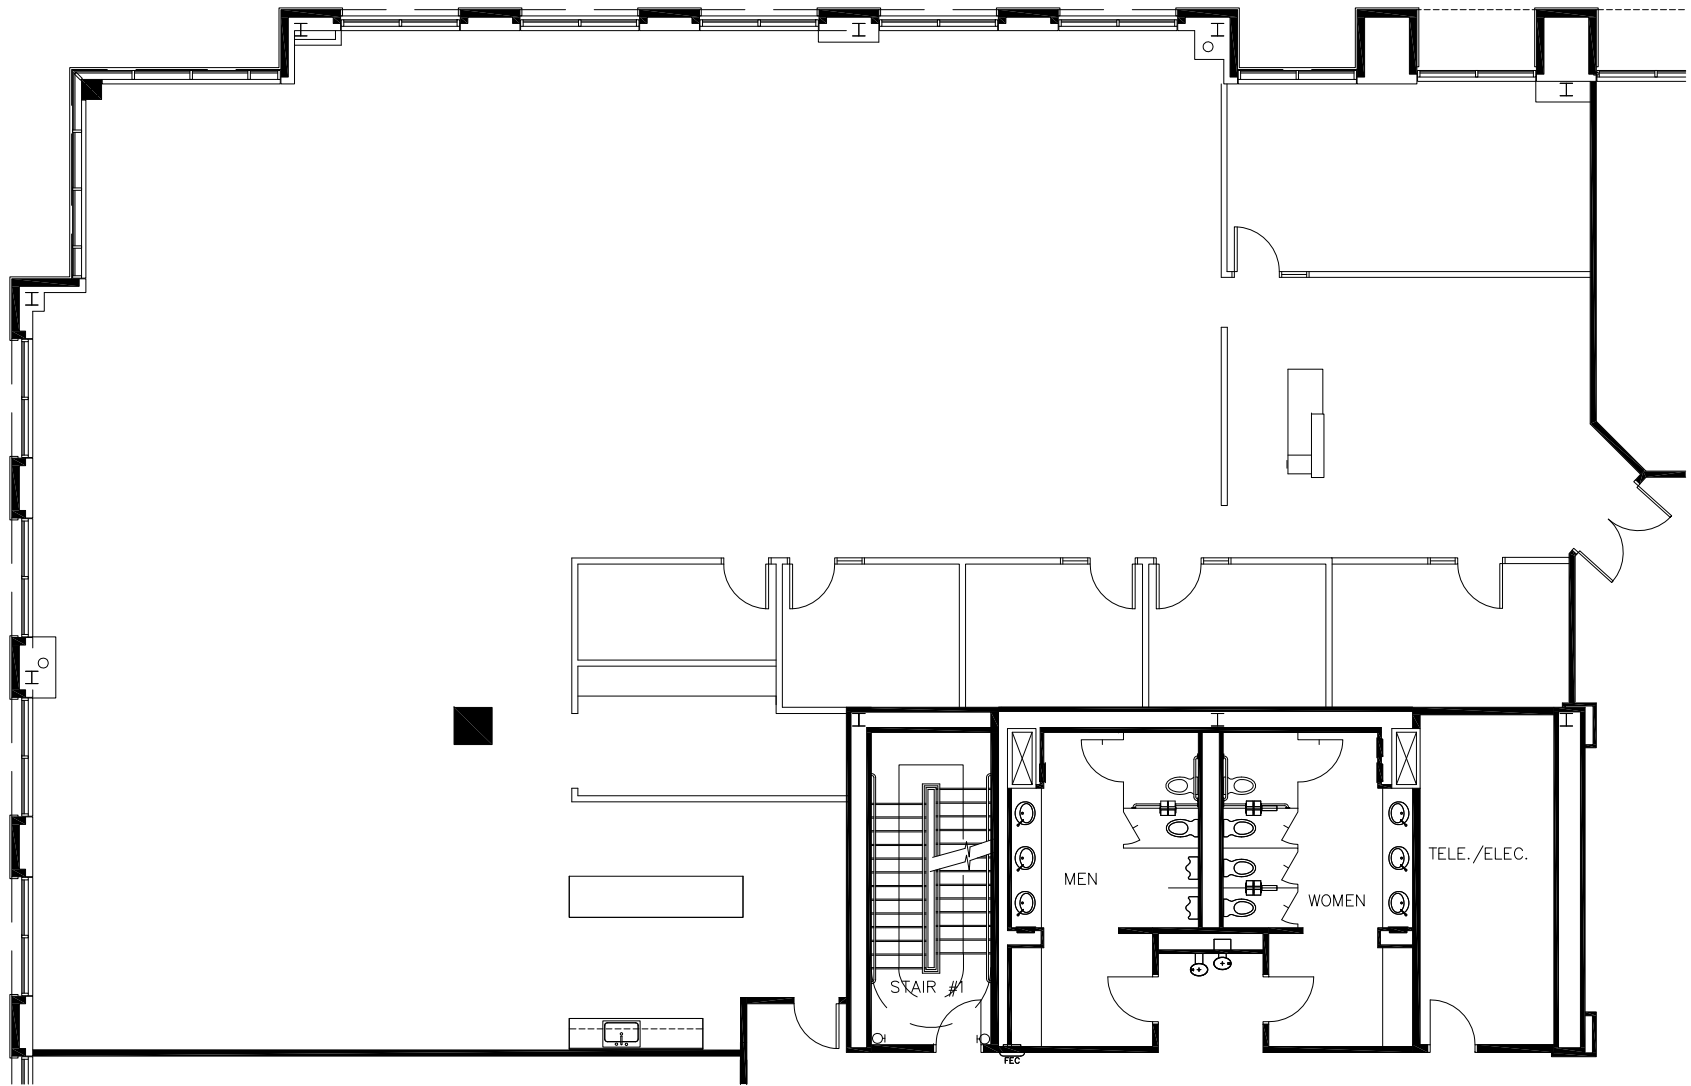

**NORTHWOOD**  
OFFICE

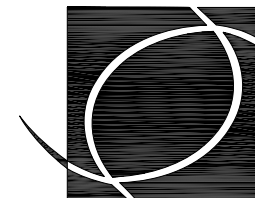

**SMITH  
HARRIS**  
**DESIGN**  
associates