



SUITE 420
 AS BUILT - 1 OF 1
 IRBY BUILDING - LEVEL FOUR
 2,517 USF / 2,920 RSF
 SCALE: 1/8" = 1'-0"
 DATE: MARCH 29, 2021

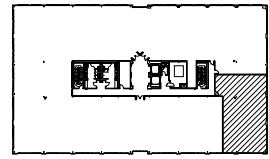

KEY PLAN

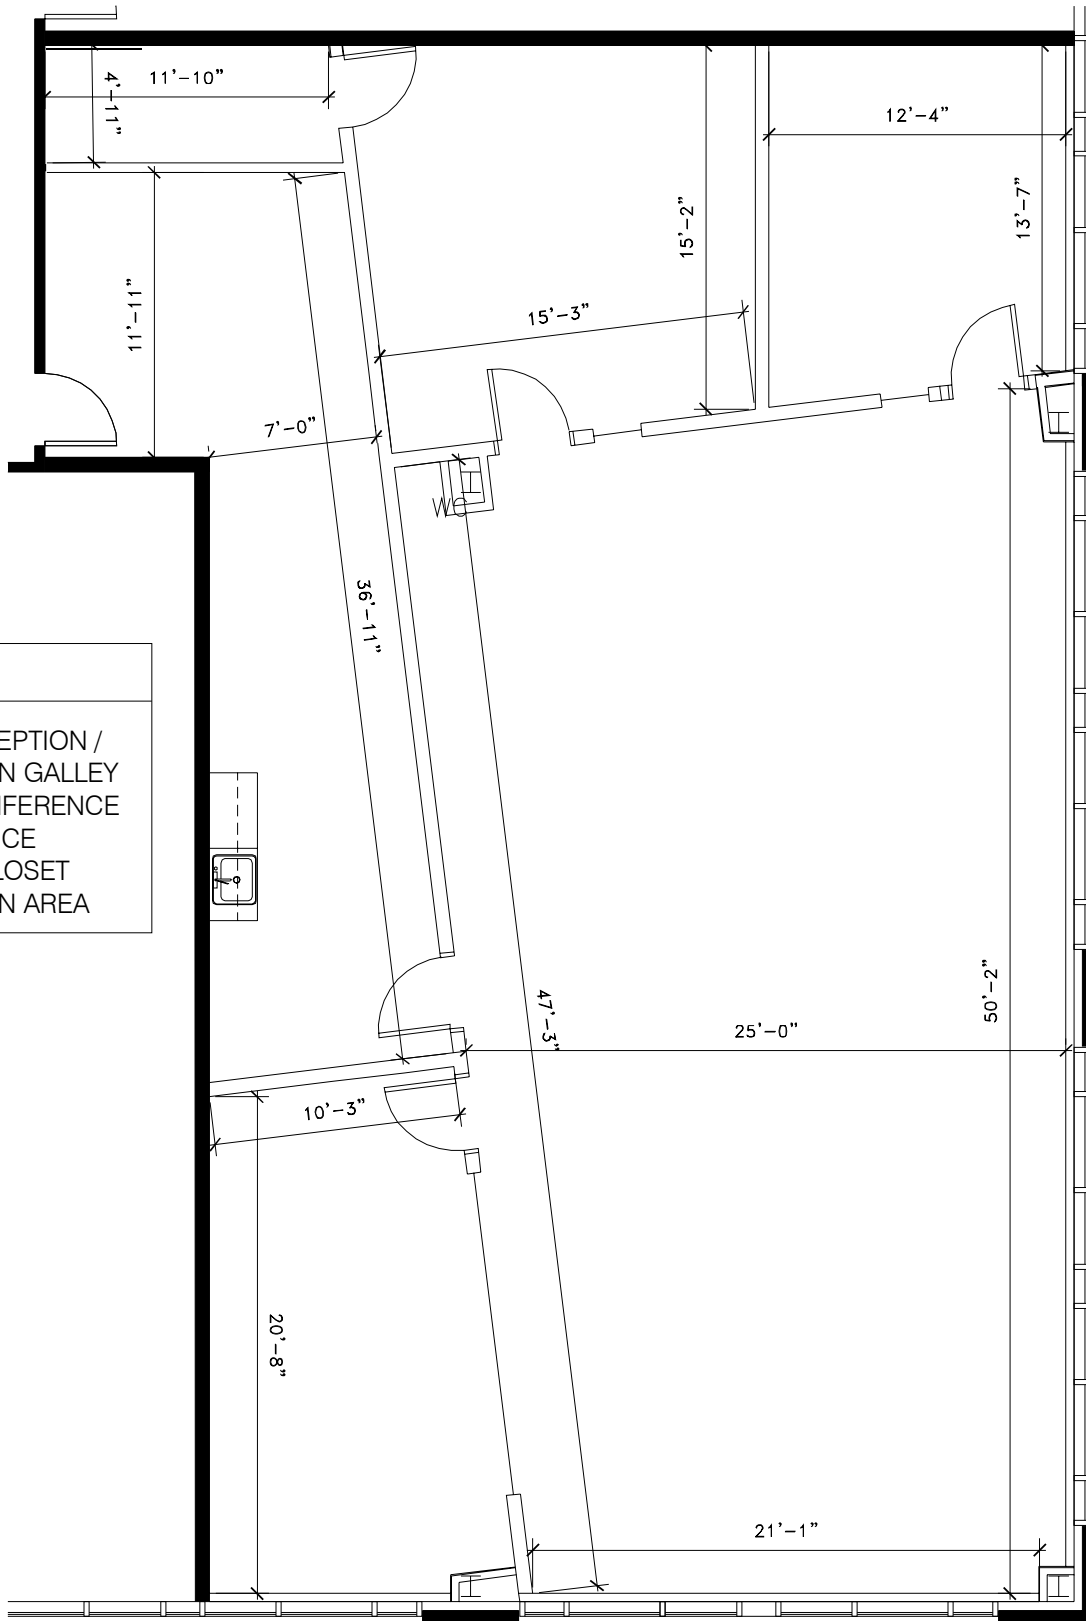

SUMMARY	
1	RECEPTION / OPEN GALLEY
1	CONFERENCE
2	OFFICE
1	IT CLOSET
1	OPEN AREA

