




SUITE 425
AS BUILT - 1 OF 1
BRIXHAM GREEN THREE - LEVEL FOUR
1,217 USF / 1,400 RSF
SCALE: 1/8"=1'-0"
DATE: APRIL 19, 2017

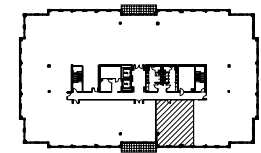

KEY PLAN

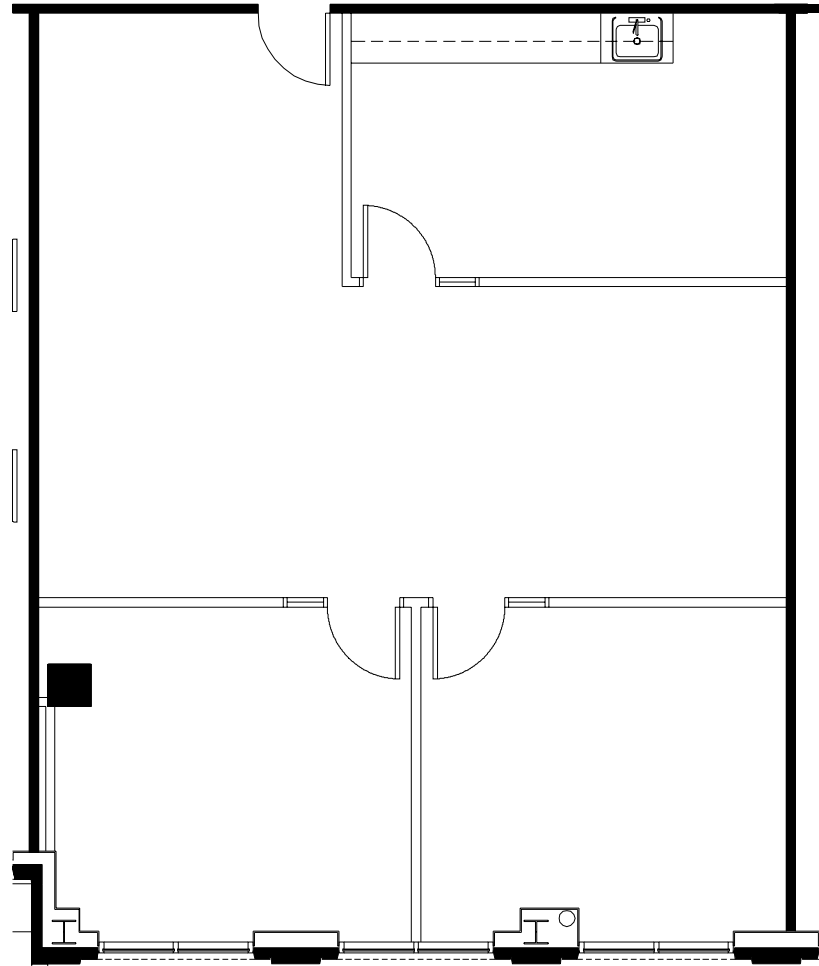

NORTHWOOD
OFFICE

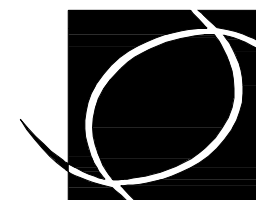

**SMITH
HARRIS**
DESIGN
associates