
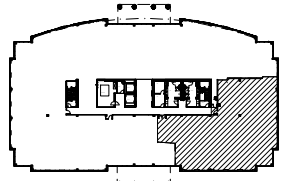


SUITE 450  
AS BUILT - 1 OF 1  
SIMMONS BUILDING - LEVEL FOUR  
5,703 USF / 6,615 RSF  
NOT TO SCALE  
DATE: JULY 9, 2019

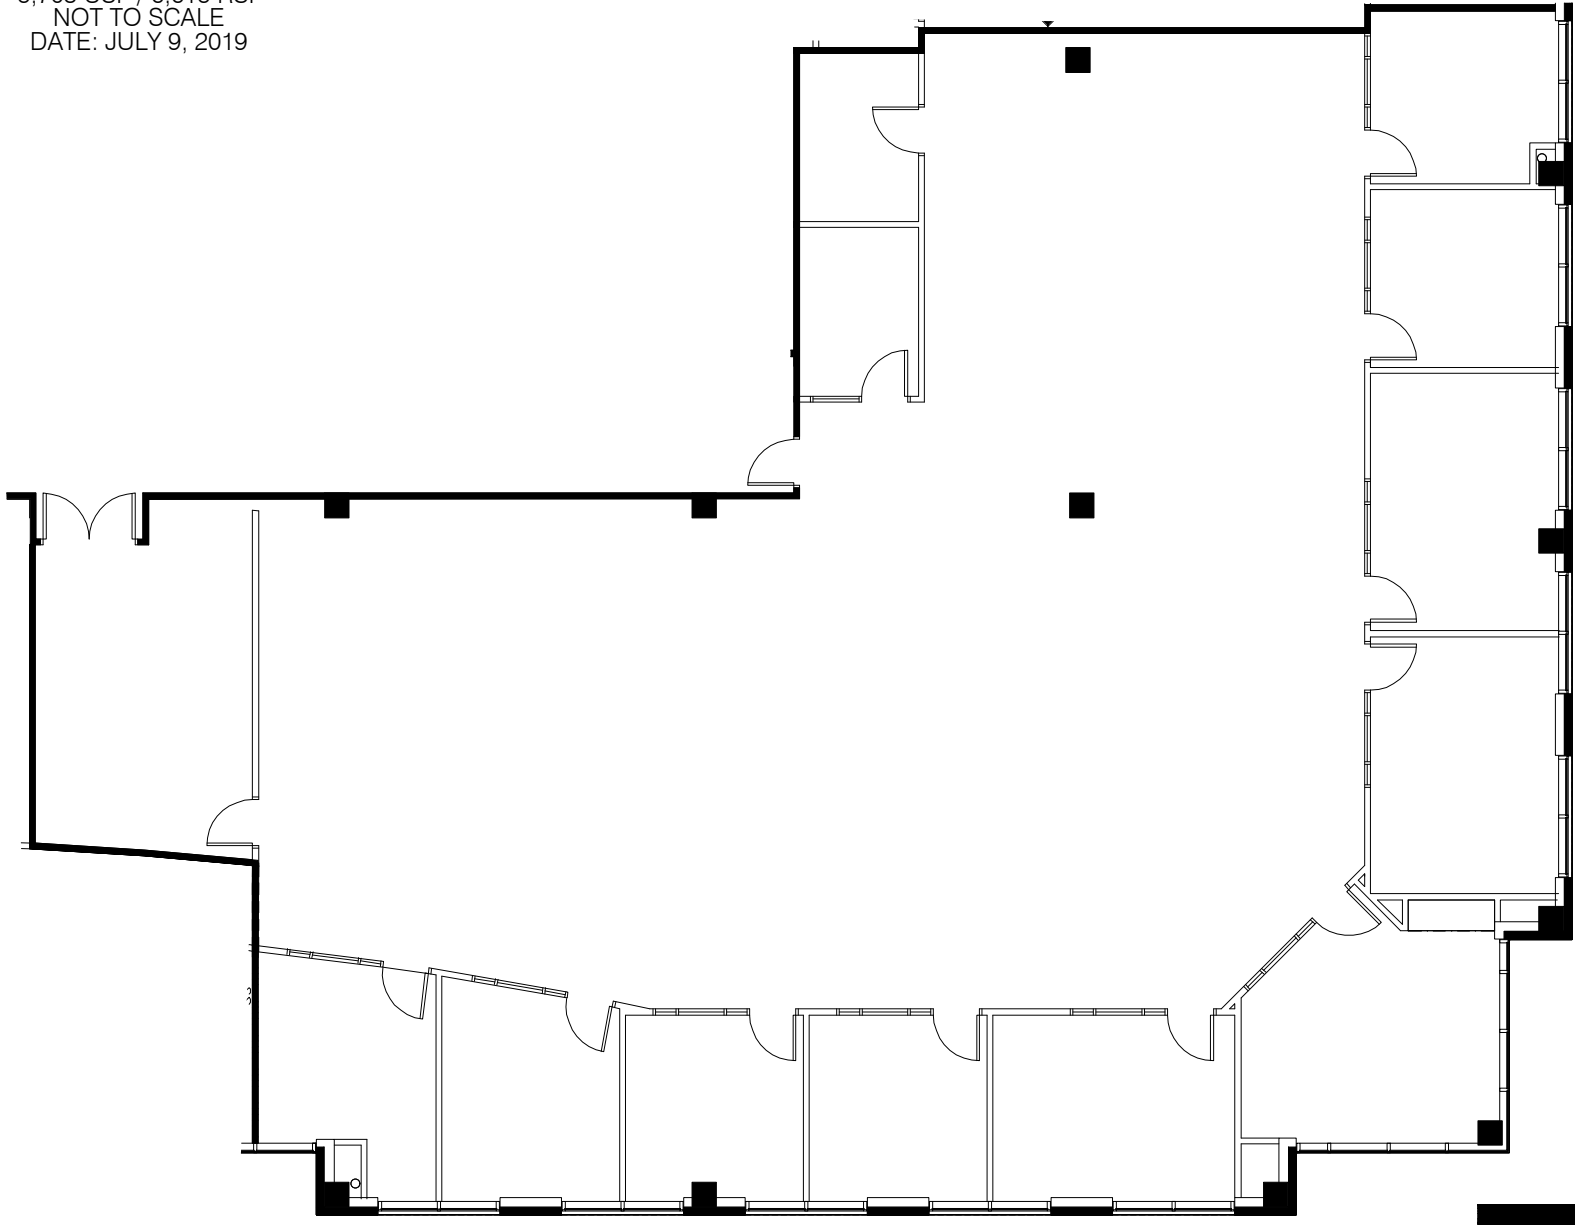

KEY PLAN