


SUITE 100
 AS BUILT - 1 OF 1
 CORPORATE VILLA F - LEVEL ONE
 3,146 RSF
 NOT TO SCALE
 DATE: FEBRUARY 9, 2021

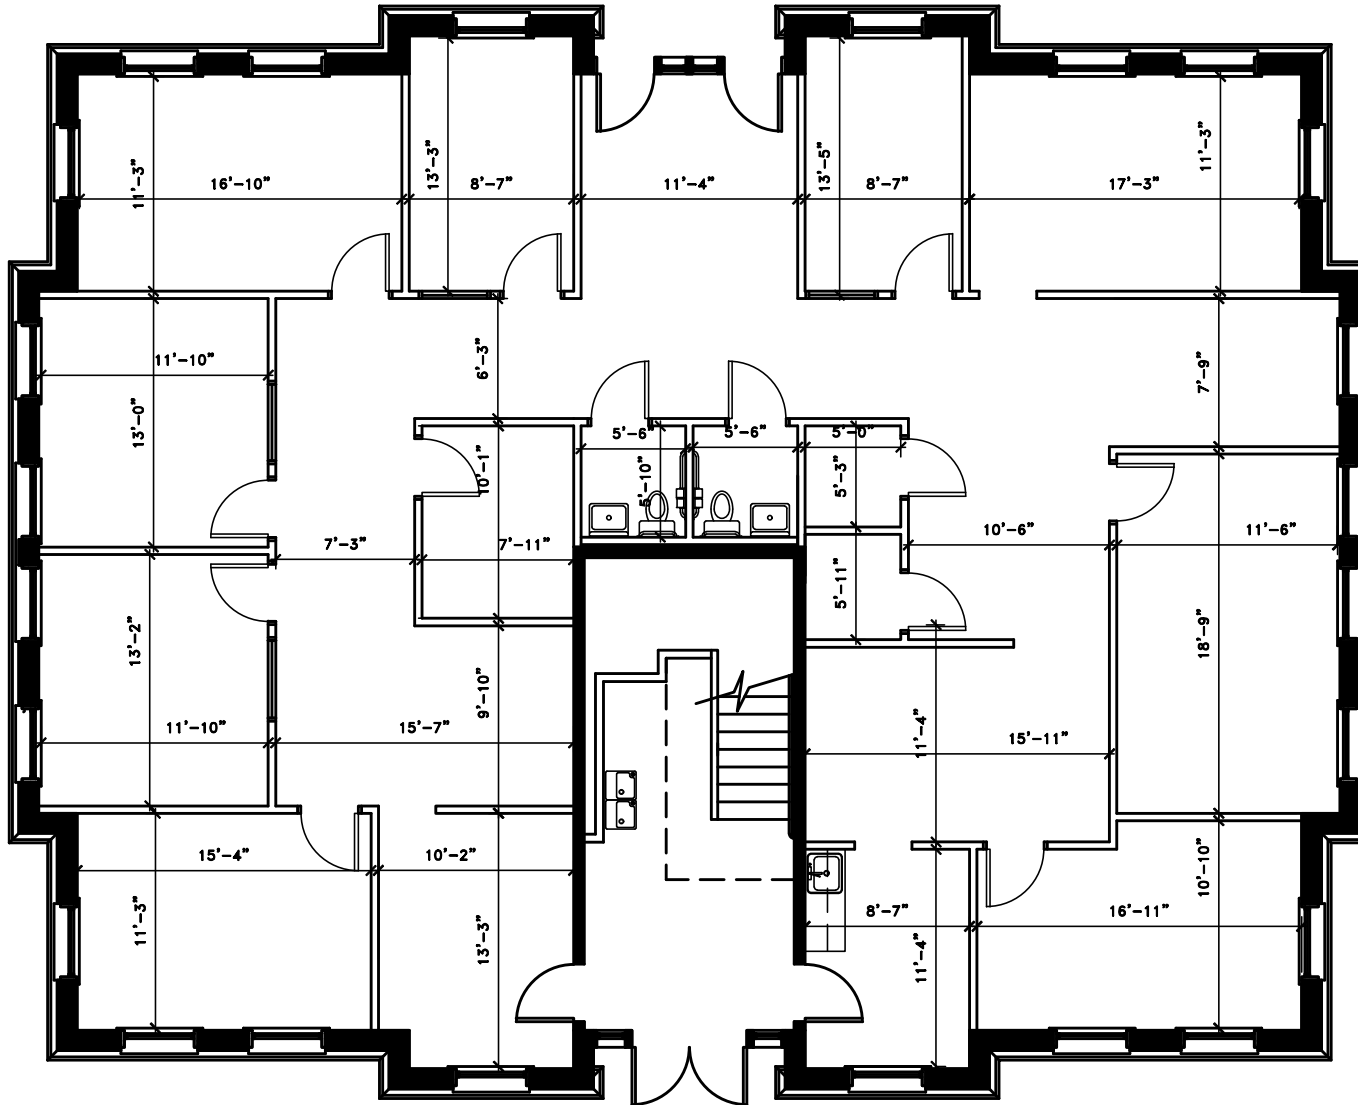

SUMMARY	
1	RECEPTION
7	PRIVATE OFFICE
1	IT ROOM
2	STORAGE
2	RESTROOMS
1	CONFERENCE
5	OPEN AREAS
1	BREAK