


SUITE 200
 AS BUILT - 1 OF 1
 CORPORATE VILLA A - LEVEL TWO
 3,424 RSF
 NOT TO SCALE
 DATE: FEBRUARY 9, 2021

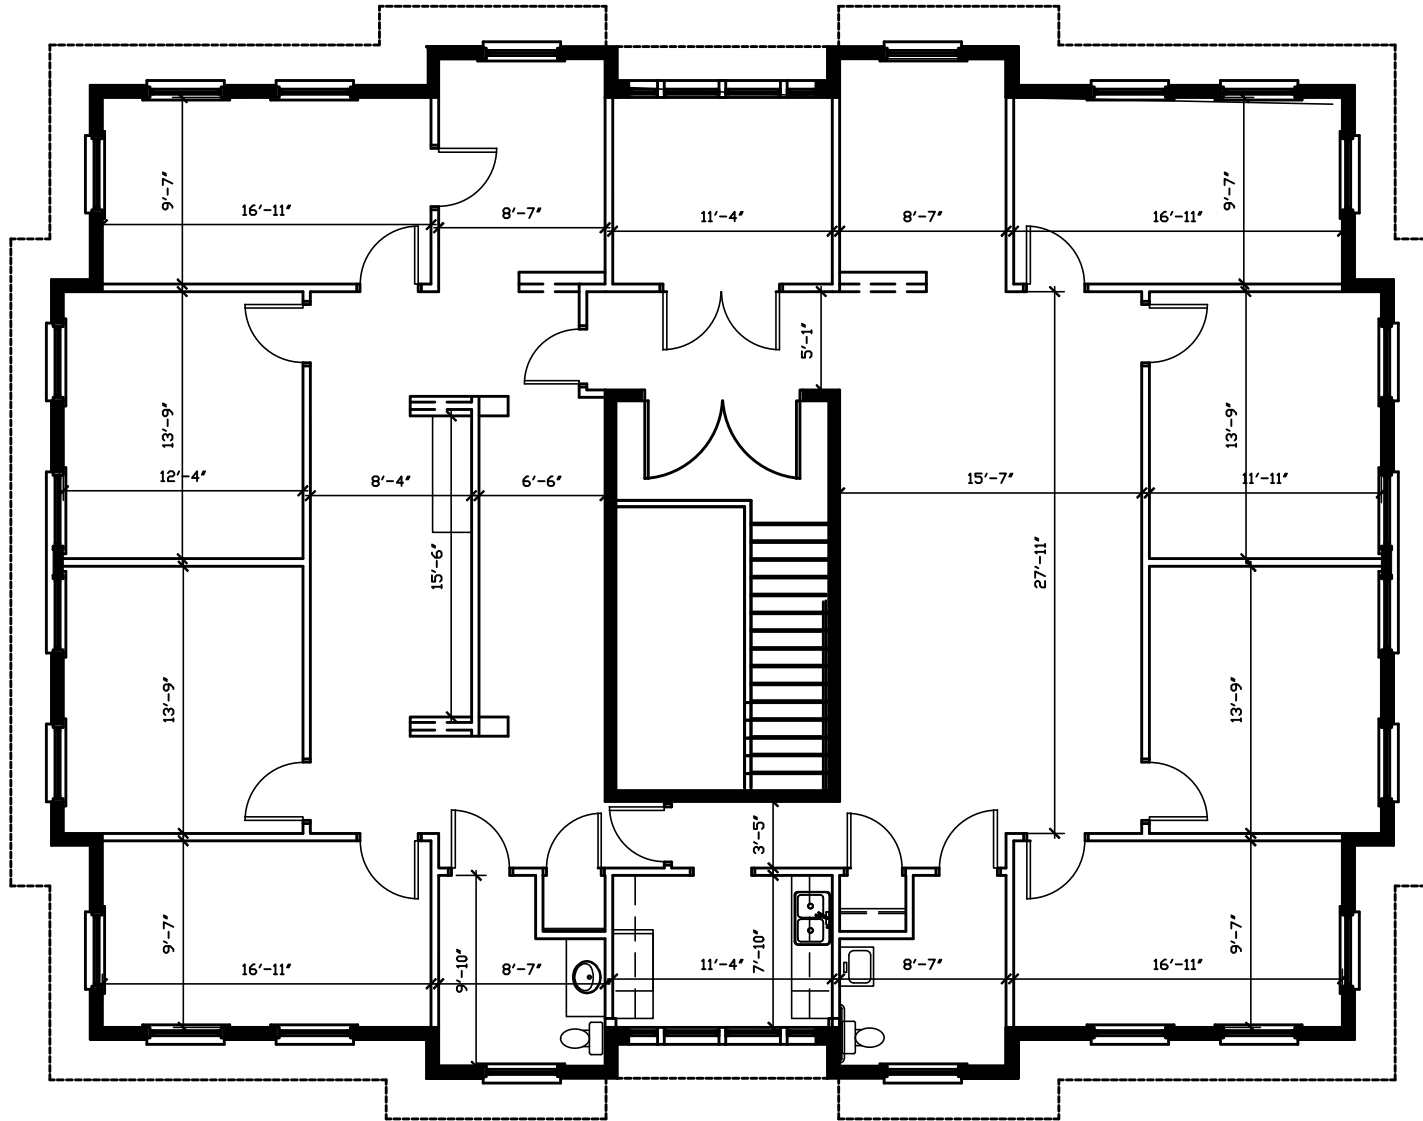

SUMMARY	
1	RECEPTION
2	ADMIN
8	PRIVATE OFFICE
2	OPEN AREA
2	RESTROOMS
1	WORK/BREAK
1	IT CLOSET
1	STORAGE