





SUITE 325
AS BUILT - 1 OF 1
BRIXHAM GREEN ONE - LEVEL THREE
2,530 USF / 2,910 RSF
SCALE: 3/32" = 1'-0"
DATE: APRIL 4, 2017

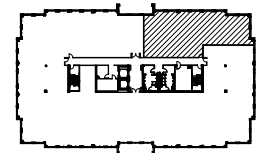

KEY PLAN

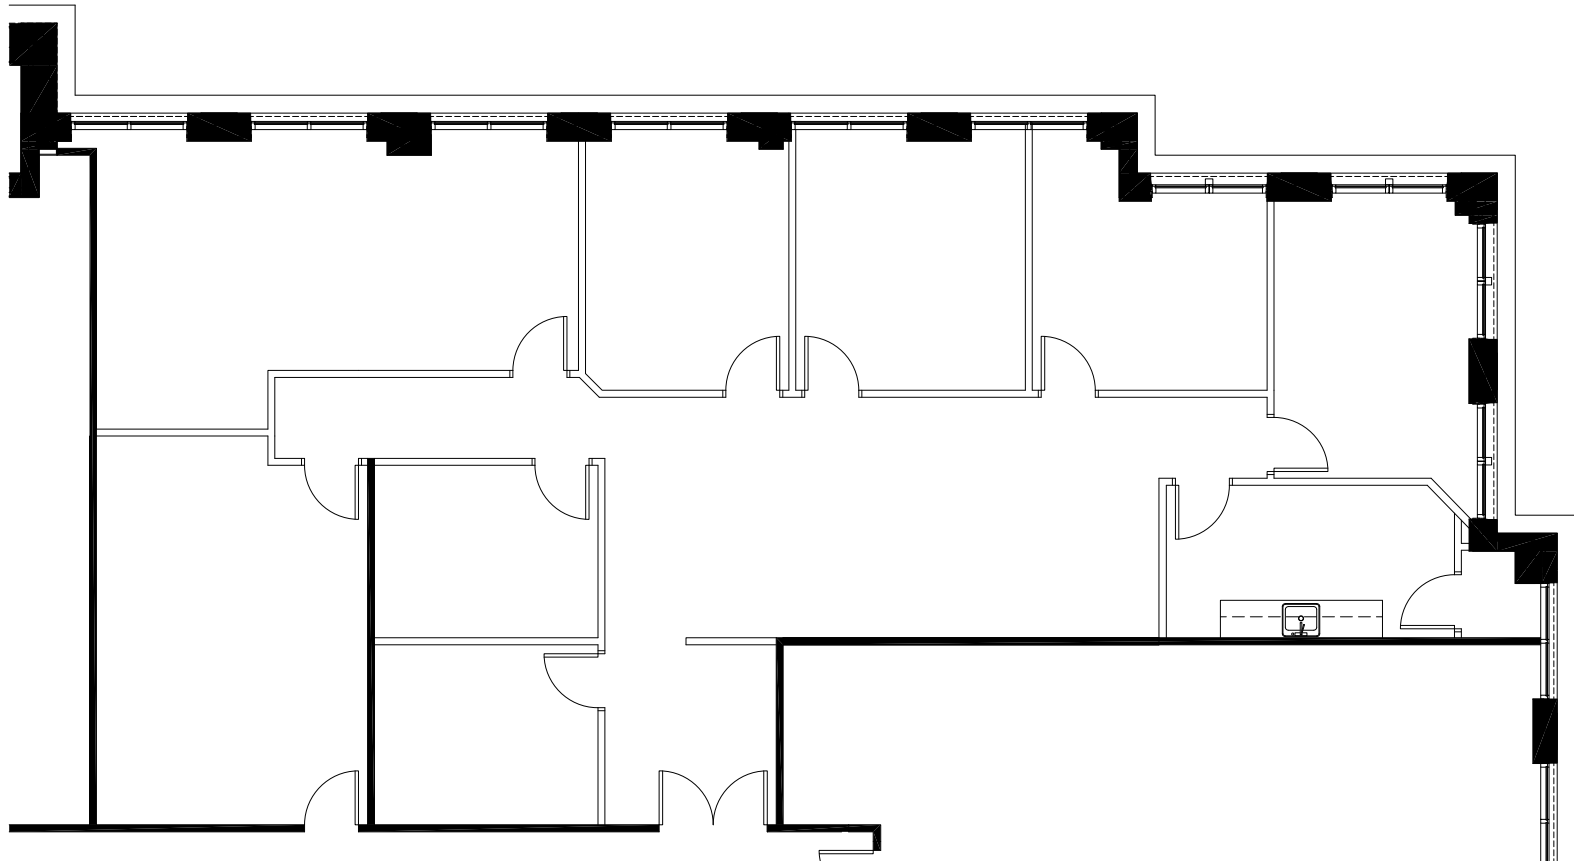

NORTHWOOD
OFFICE

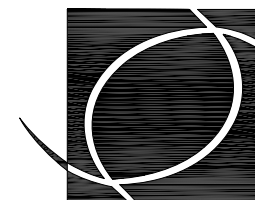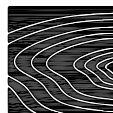

**SMITH
HARRIS**
DESIGN
associates