





SUITE 550  
 AS BUILT - 1 OF 1  
 EVERETT BUILDING - LEVEL FIVE  
 12,791 USF / 14,837 RSF  
 NOT TO SCALE  
 DATE: JUNE 23, 2021

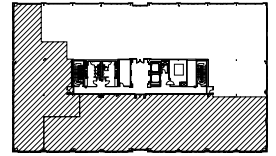

KEY PLAN

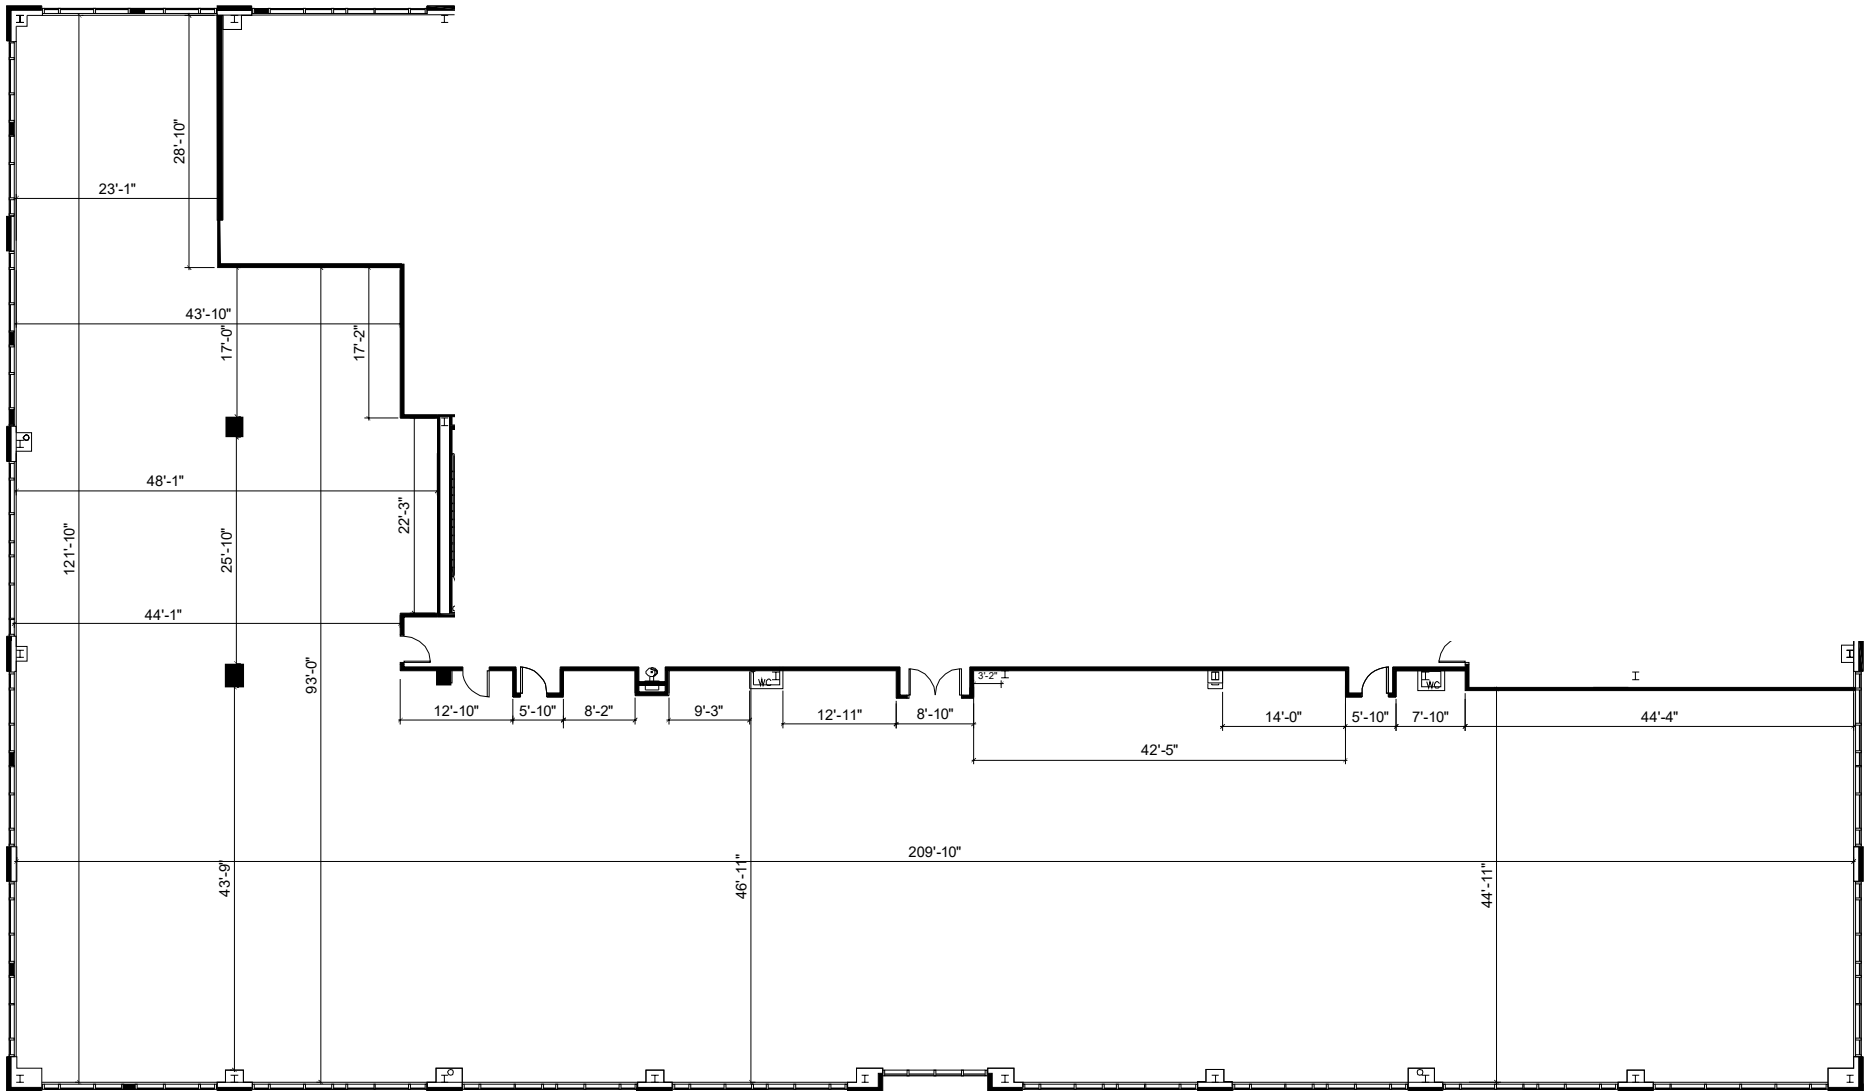

**NORTHWOOD**  
 OFFICE

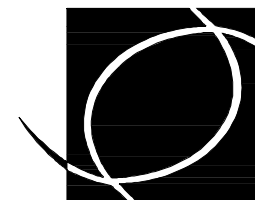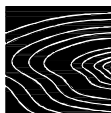

**SMITH  
 HARRIS**  
 DESIGN  
 associates