


SUITE 100
 AS BUILT - 1 OF 1
 RICHARDSON - LEVEL ONE
 1,860 USF / 2,158 RSF
 SCALE: 1/8" = 1'-0"
 DATE: APRIL 22, 2021

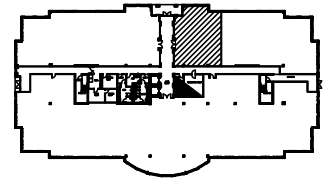

KEY PLAN

SUMMARY	
1	ENTRY
3	PRIVATE OFFICE
1	BREAK
1	STORAGE/IT
1	CONFERENCE
1	OPEN AREA

