


SUITE 100  
 AS BUILT - 1 OF 1  
 CURRAN - LEVEL ONE  
 1,860 USF / 2,158 RSF  
 SCALE: 1/8" = 1'-0"  
 DATE: APRIL 22, 2021

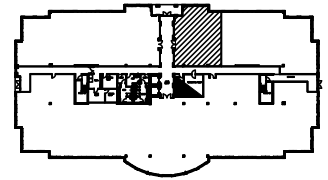

KEY PLAN

SUMMARY	
1	ENTRY
3	PRIVATE OFFICE
1	BREAK
1	STORAGE/IT
1	CONFERENCE
1	OPEN AREA

