



SUITE 250
 AS BUILT - 1 OF 1
 BRIXHAM GREEN III - LEVEL TWO
 7,647 USF / 8,871 RSF
 SCALE: 1/16" = 1'-0"
 DATE: MARCH 5, 2021

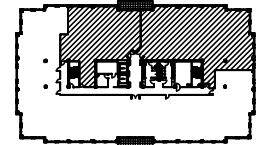

KEY PLAN

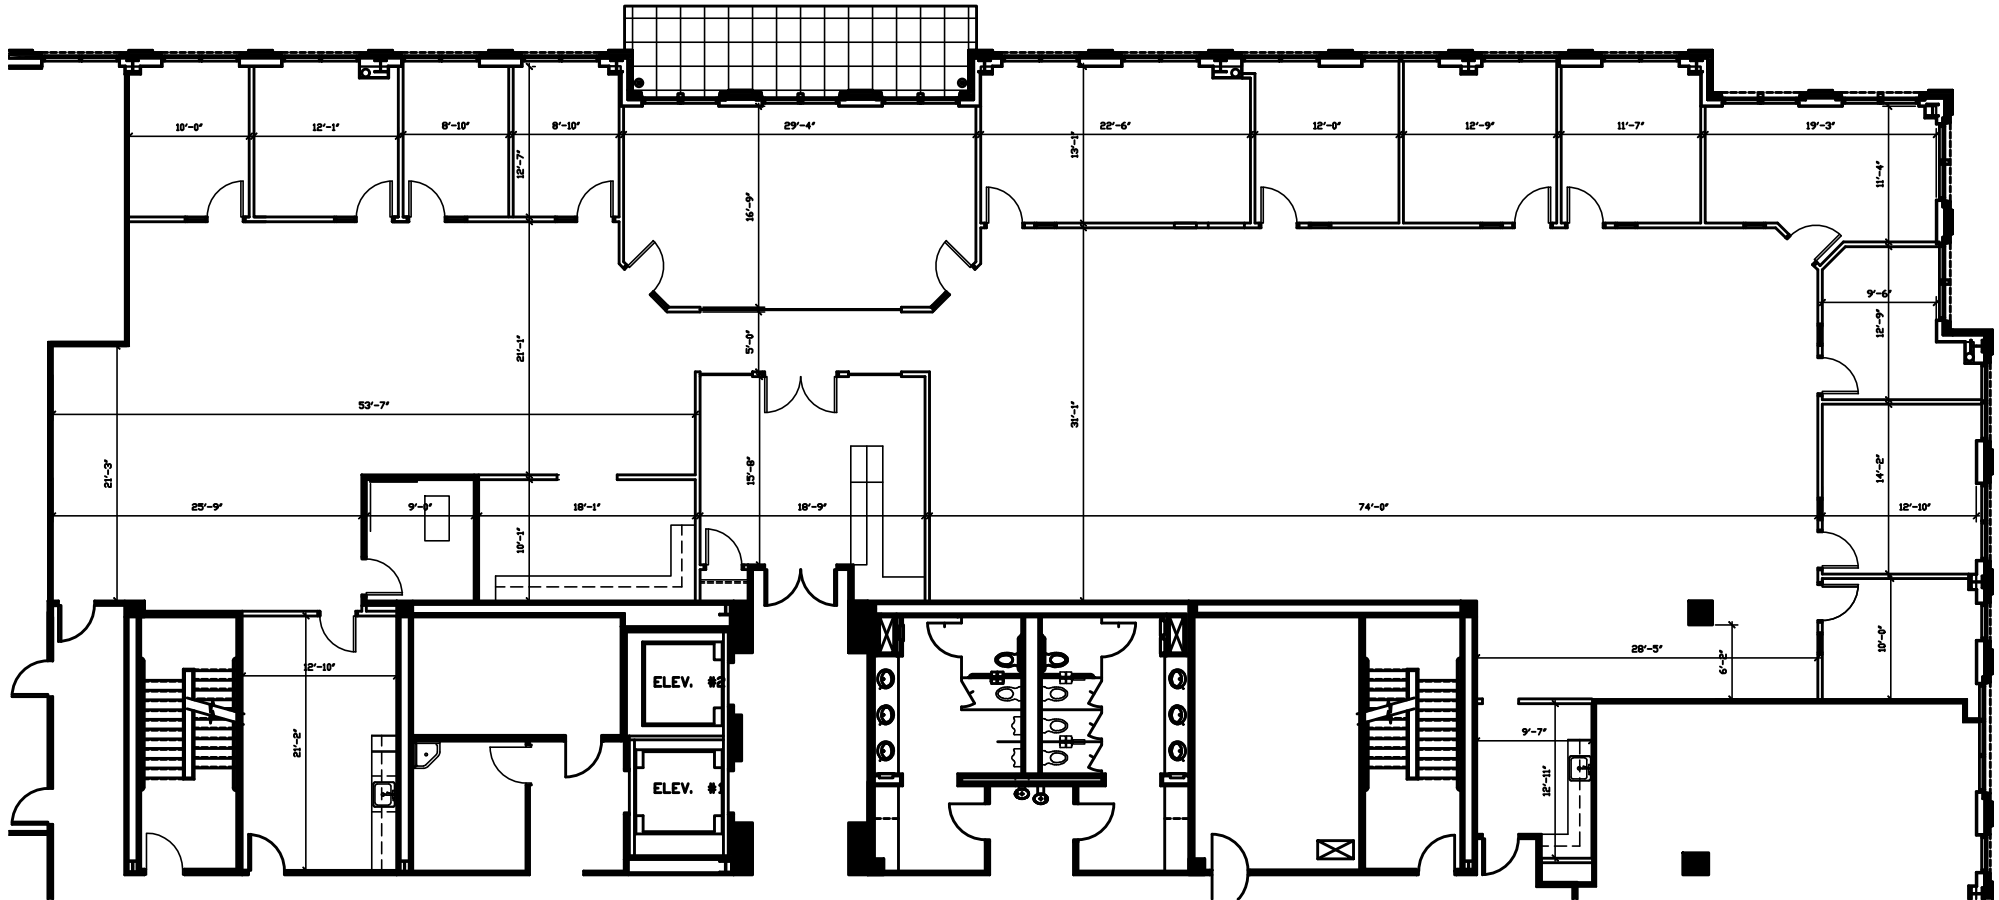

SUMMARY	
1	RECEPTION
2	CONFERENCE
11	PRIVATE OFFICE
1	WORK ROOM
2	BREAK ROOMS
1	IT ROOM
1	STORAGE