


SUITE 155
AS BUILT - 1 OF 1
RICHARDSON - LEVEL ONE
2,290 USF / 2,656 RSF
SCALE: 1/8" = 1'-0"
DATE: OCTOBER 22, 2019

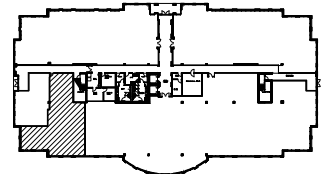

KEY PLAN

