




SUITE 500
AS BUILT - 1 OF 1
EVERETT BUILDING - LEVEL FIVE
9,952 USF / 11,544 RSF
NOT TO SCALE
DATE: NOVEMBER 6, 2018

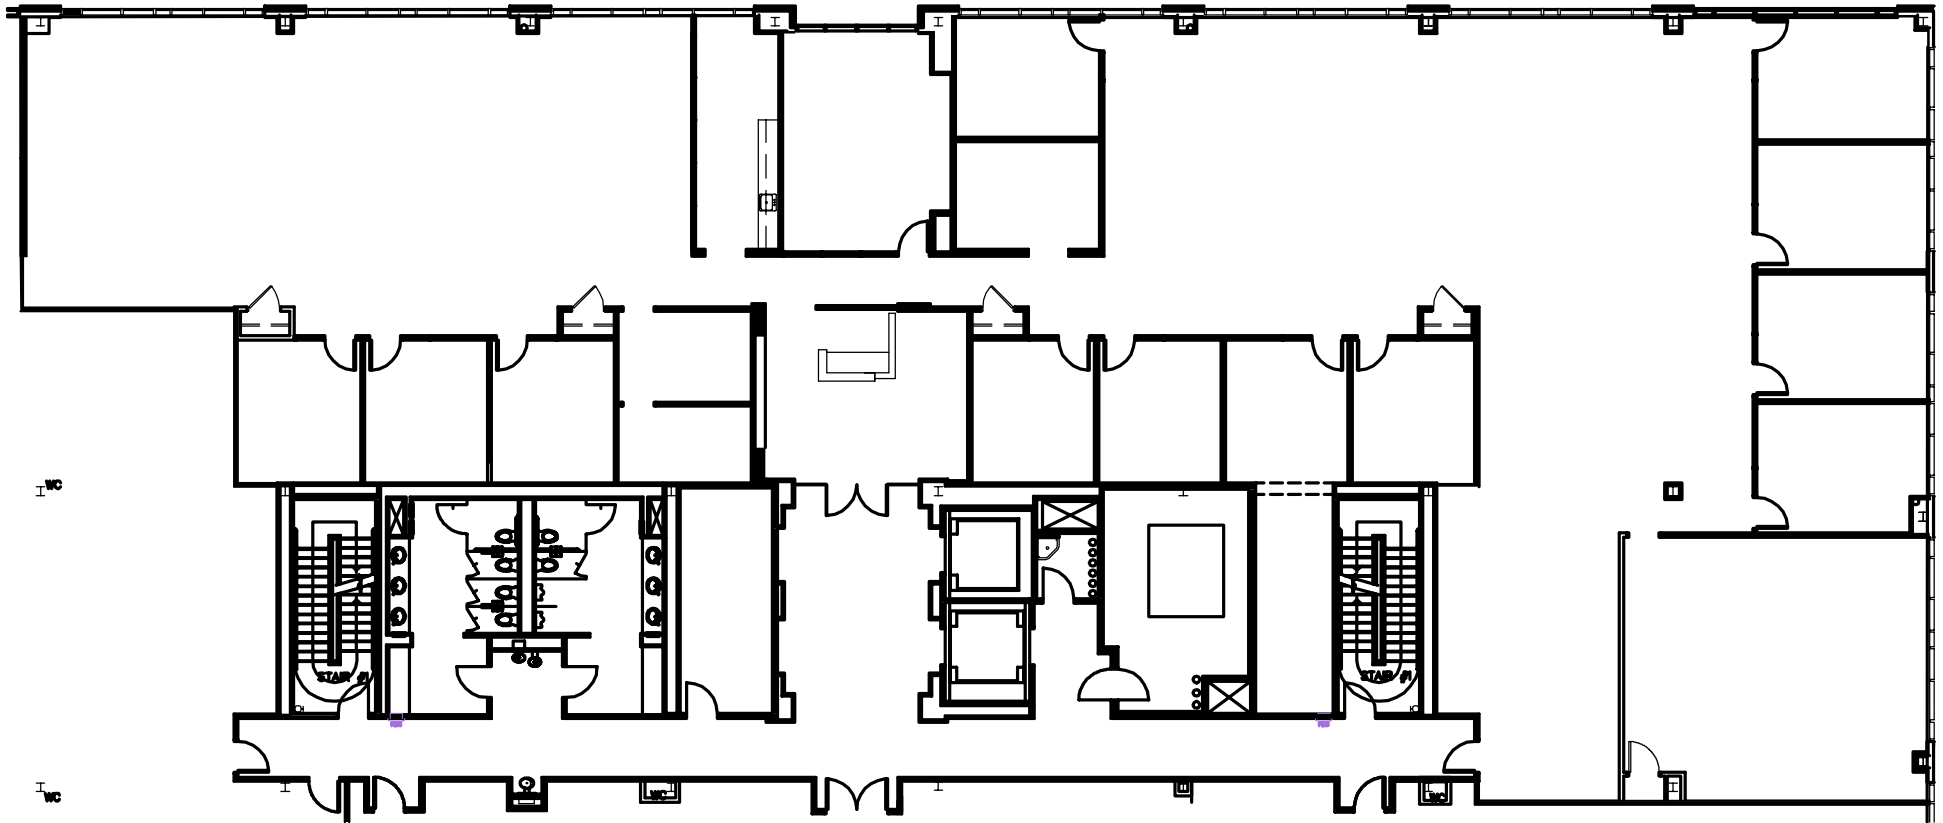

KEY PLAN



NORTHWOOD
OFFICE

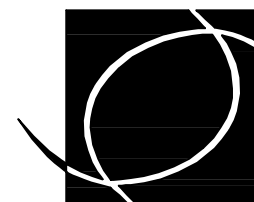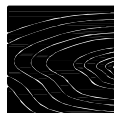

**SMITH
HARRIS
DESIGN**
associates