


SUITE 500
 AS BUILT - 1 OF 1
 EVERETT BUILDING - LEVEL FIVE
 9,952 USF / 11,544 RSF
 NOT TO SCALE
 DATE: JUNE 18, 2021

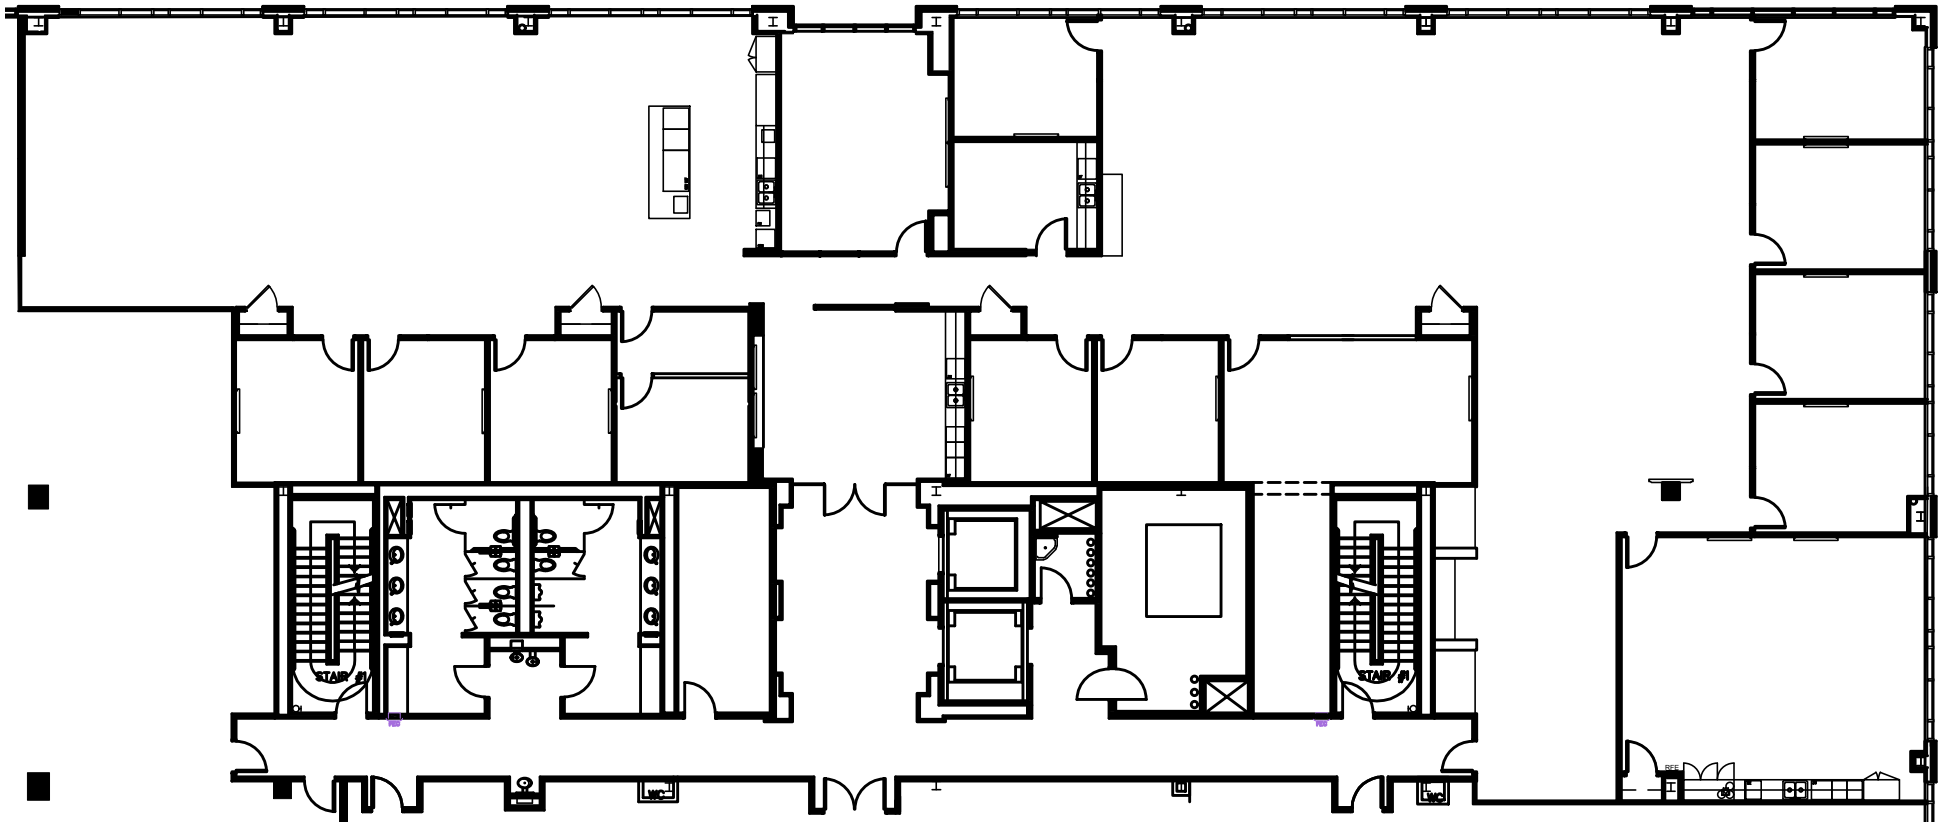

KEY PLAN



SUMMARY	
1	RECEPTION
12	CONFERENCE/MEETING
1	BREAK ROOM
1	IT ROOM
4	STORAGE
1	HEALTH ROOM
1	GAME ROOM
1	LIBRARY
2	OPEN AREA