


SUITE 600
AS BUILT - 1 OF 1
HARRIS BUILDING - LEVEL SIX
6,730 USF / 7,816 RSF
NOT TO SCALE
DATE: DECEMBER 18, 2019

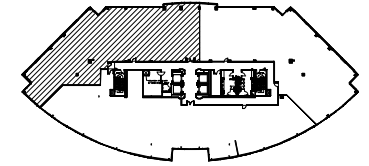

KEY PLAN

